



1 | 2 | 3 | 4 | 5 | 6 | 7 | 8

See Drw 1050E10
Power Wire Diagram

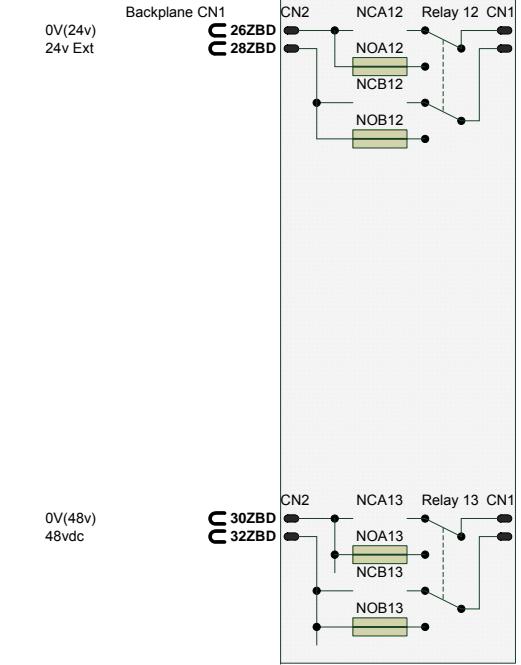


Backplane CN8
Serial Card 2 1050E95

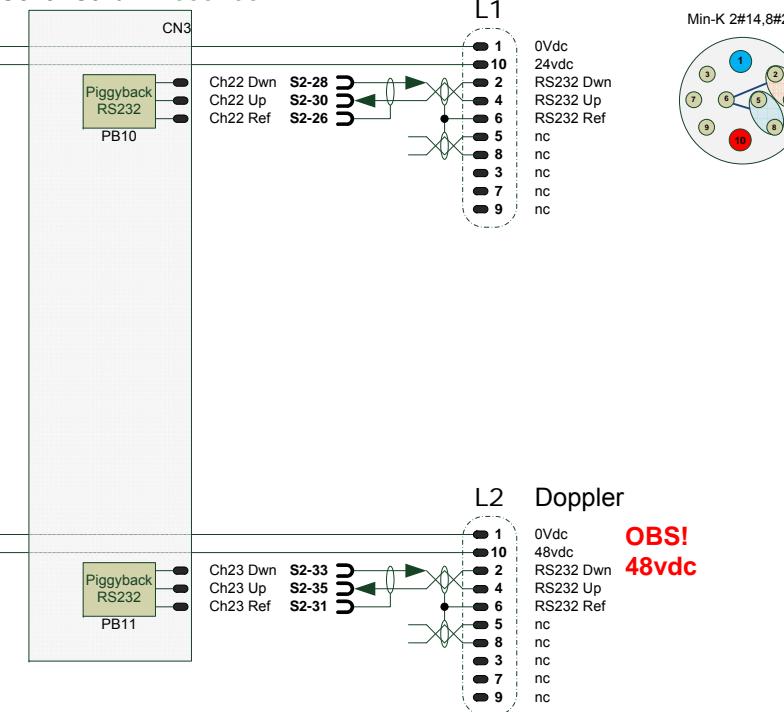


OBS!
48vdc

See Drw 1050E10
Power Wire Diagram

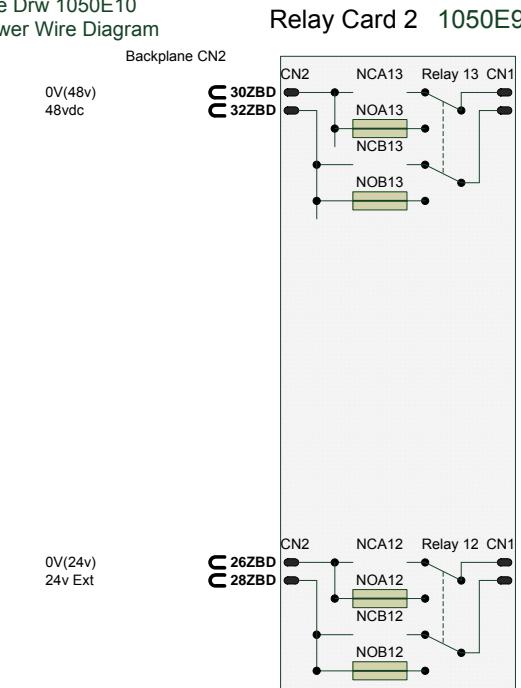


Serial Card 3 1050E95

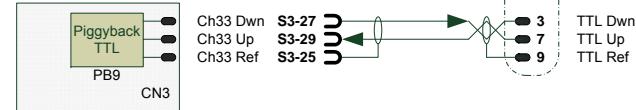


OBS!
48vdc

Serial Card 3 1050E95

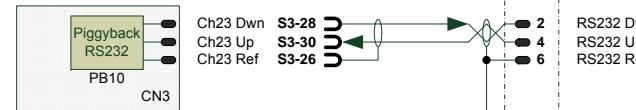

Master Card 1050E95

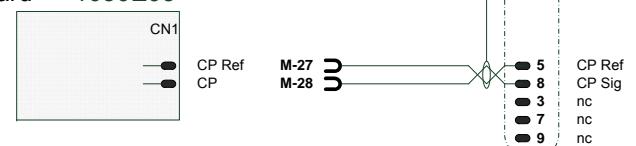

Rev Date Issue
B 26 08 15 Draft
1 17 03 16 As Built

Prep. by Ch. by Appr. by
KST TBH EKB
KST TBH EKB

Strandgaten 202, 5525
Haugesund NORWAY
Tel +47 52 70 62 50
Fax +47 52 70 62 01
www.kystdesign.no

Document Title

Constructor 5 & 6
Control Pod L1-M2 Wire Diagram

Kystdesign AS Drawing No.

SheetNo

AF57-1-1050E25

1 of 1

Scale Revision
A3 1

1 | 2 | 3 | 4 | 5 | 6 | 7 | 8