



1 | 2 | 3 | 4 | 5 | 6 | 7 | 8


See Drw 1050E10  
Power Wire Diagram

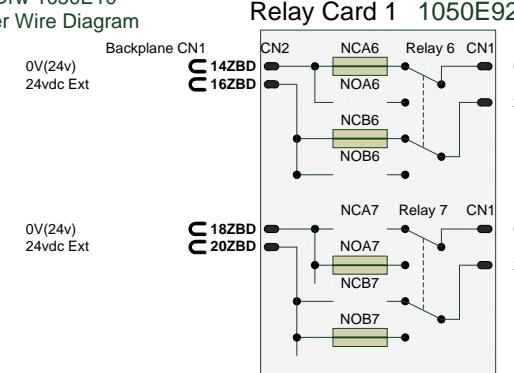


### Serial Card 1 1050E95

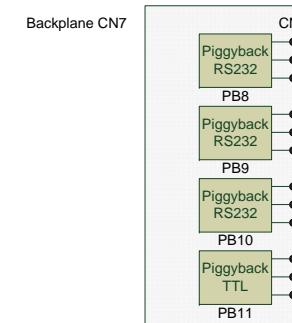


### Serial Card 3 1050E95

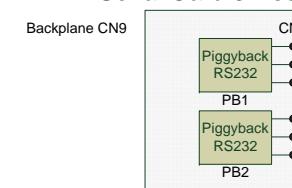


### E1 Gyro 1

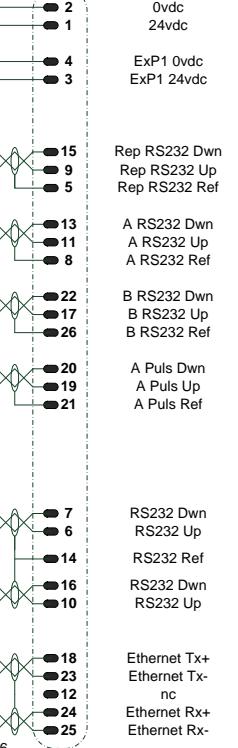


See Drw 1050E10  
Power Wire Diagram

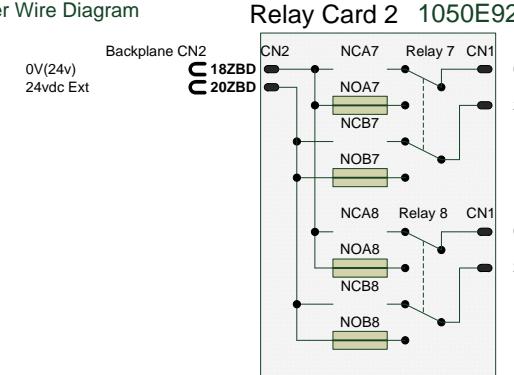

### Serial Card 3 1050E95

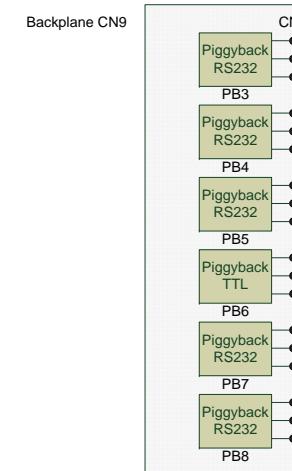

### E2 Gyro 2

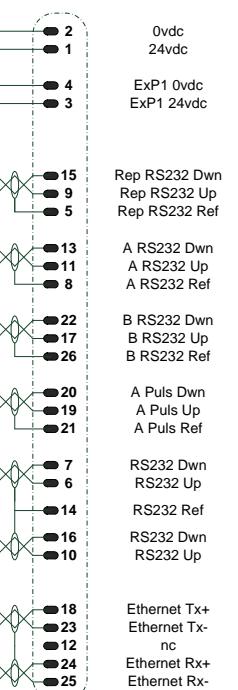

Rev	Date	Issue	Prep. by	Ch. by	Appr. by
B	26 08 15	Draft	KST	TBH	EKB
1	17 03 16	As Built	KST	TBH	EKB



Strandgaten 202, 5525  
Haugesund NORWAY  
Tel +47 52 70 62 50  
Fax +47 52 70 62 01  
www.kystdesign.no

Document Title  
**Constructor 5 & 6**  
Control Pod E1, E2 Gyro Wire Diagram

Kystdesign AS Drawing No.	SheetNo
AF57-1-1050E21	1 of 1
Scale A3	Revision 1