


in the information contained therein. Reproduction, use or disclosure to third parties without consent is strictly forbidden.

KYSTDESIGN AS

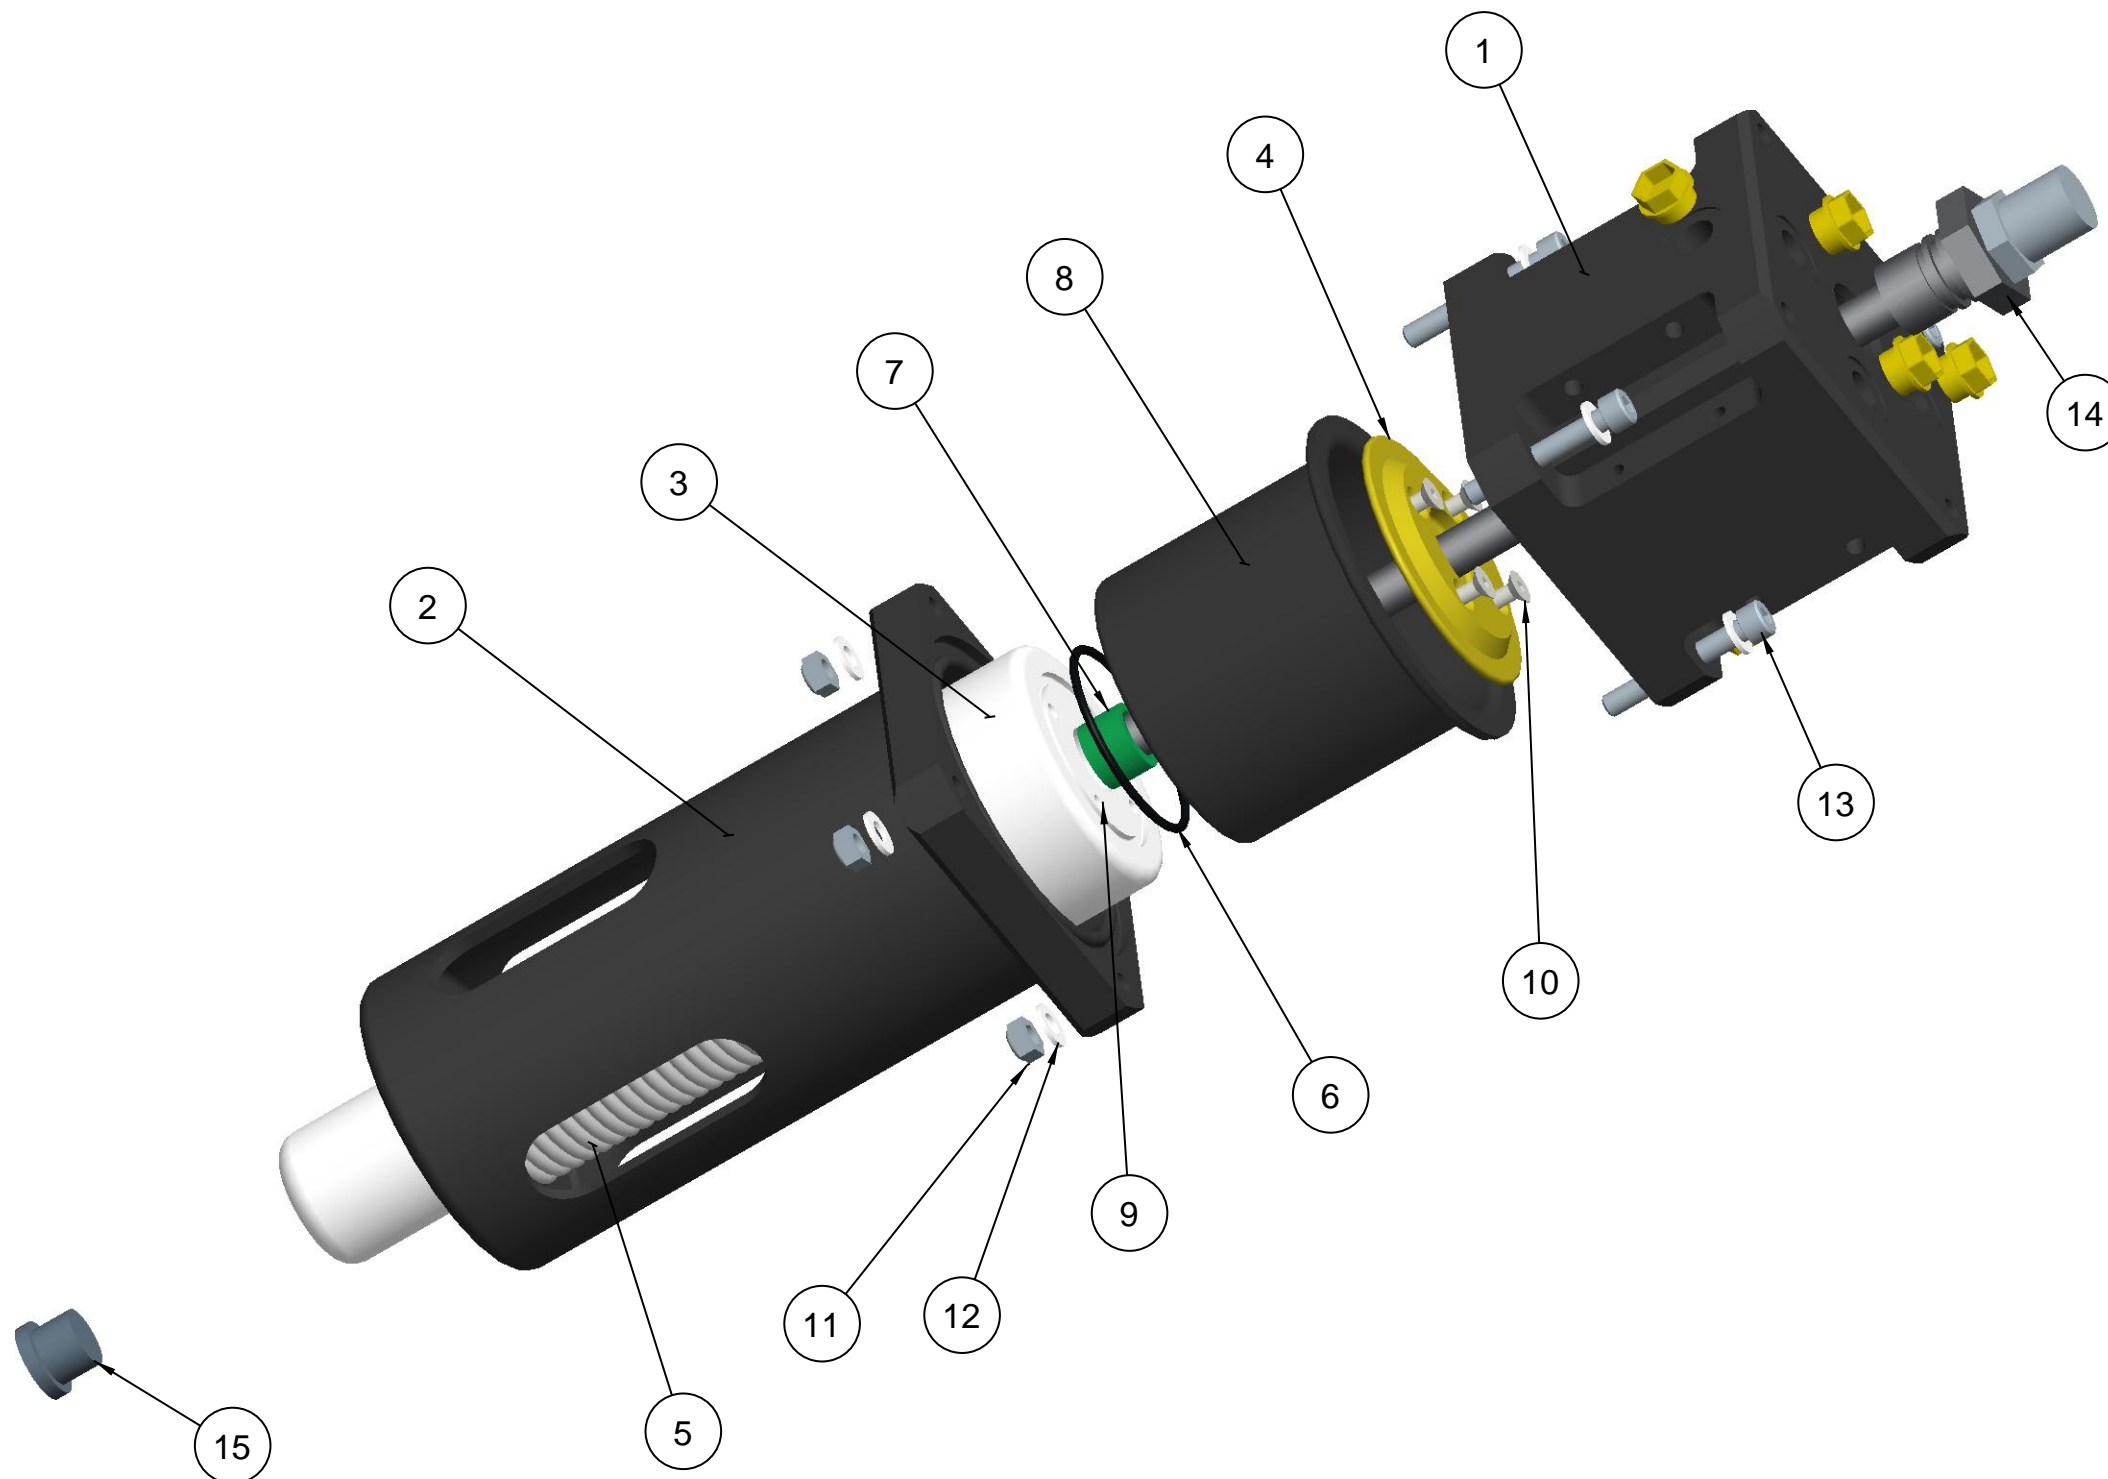

Capacity.....1,2 L
Pressure.....0,15 - 0,55 Bar
Hydraulic Connection...3/8" BSP
Length excl. sensor.....351 mm
Length incl. sensor.....558 mm
Width.....125 mm
Weight.....5,2 kg
Volume Sensor:.....Optional





Itm.	Qty.	Description	Drg. / Spec.	Material
15	1	Plug 1/2" BSP		
14	1	Linear Sensor		
13	4	M8X55 Socket Head Cap Screw	DIN 912	A4
12	8	M8 Washer	DIN 125A	A4
11	4	M8 Nylock nut	DIN 985	A4
10	4	M6x20 Countersunk Screw	DIN 7991	A4
9	4	M6 Threaded insert	Ensat30206050	A4
8	1	Diaphragm 100X90X100	BFA	
7	1	Magnet		
6	1	O-ring	58x3	NBR 70
5	1	Spring, \varnothing 5X60X352		SS
4	1	Diaphragm Disk	AB89-1037M14	
3	1	Piston	AB89-1037M13	
2	1	Compensator house - SW side	AB89-1037M12	
1	1	Compensator house - Oil side	AB89-1037M11	

Rev.	Date	Description	Prep	Chk	App
02	23.04.02	AS BUILT	GVI	AHO	PGE
01	28.11.01	ISSUED FOR PRODUCTION	GVI	AHO	PGE
A	24.08.01	ISSUED FOR COMMENTS	AHO	EKB	PGE



 
Drawing title Compensator - 1,2 litre Assembly		Size A3	
KYSTDESIGN AS Strandgaten 202, 5525 Haugesund, NORWAY Tel: +47 52 70 62 50 Fax: +47 52 70 62 01 www.kystdesign.no		Scale 2:5	Sheet 1
File name AB89-1037M01		of 2	

in the information contained therein. Reproduction, use or disclosure to third parties without consent is strictly forbidden.
KYSTDESIGN AS

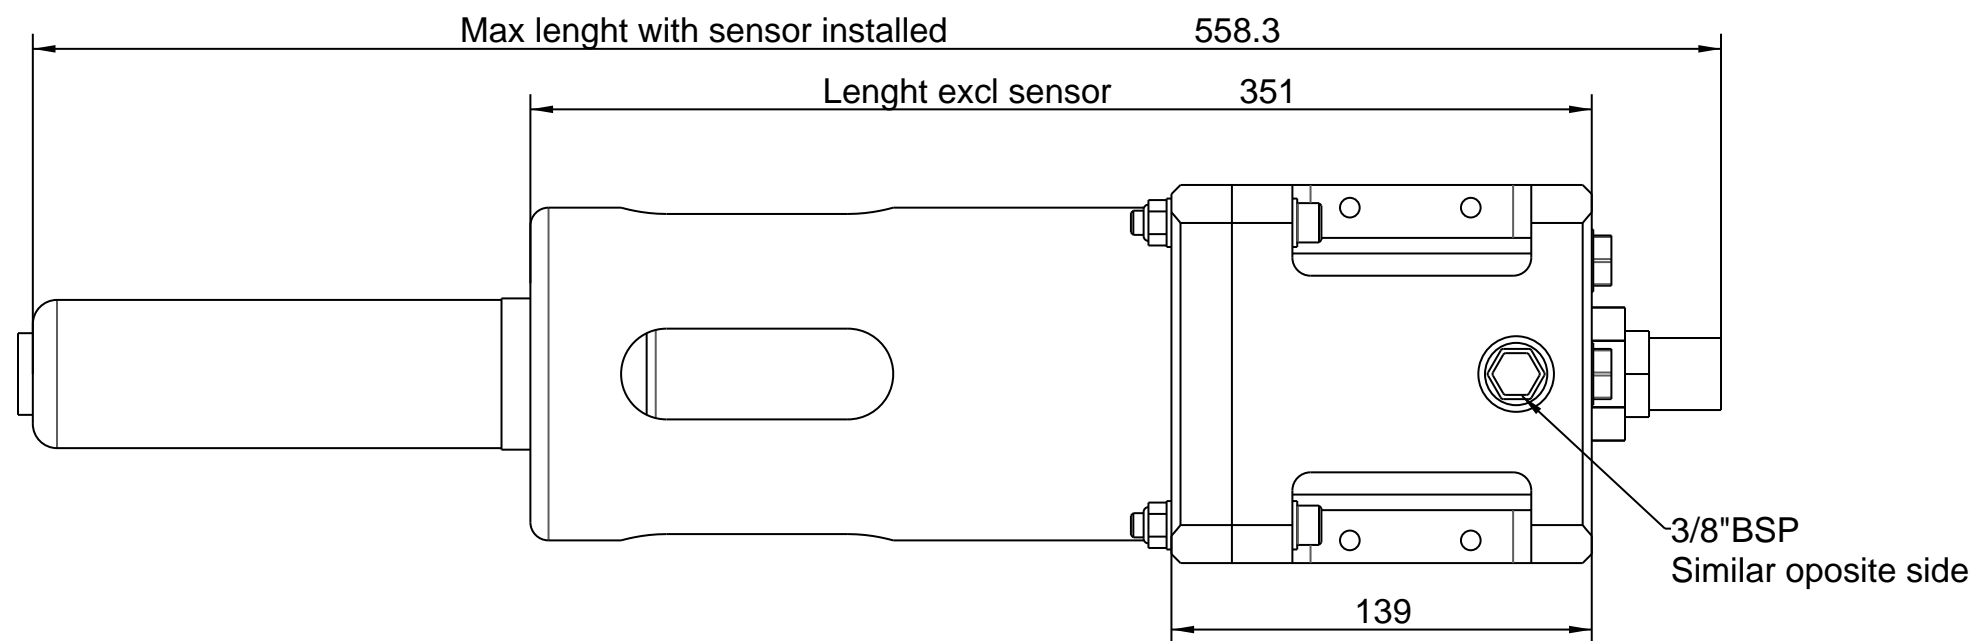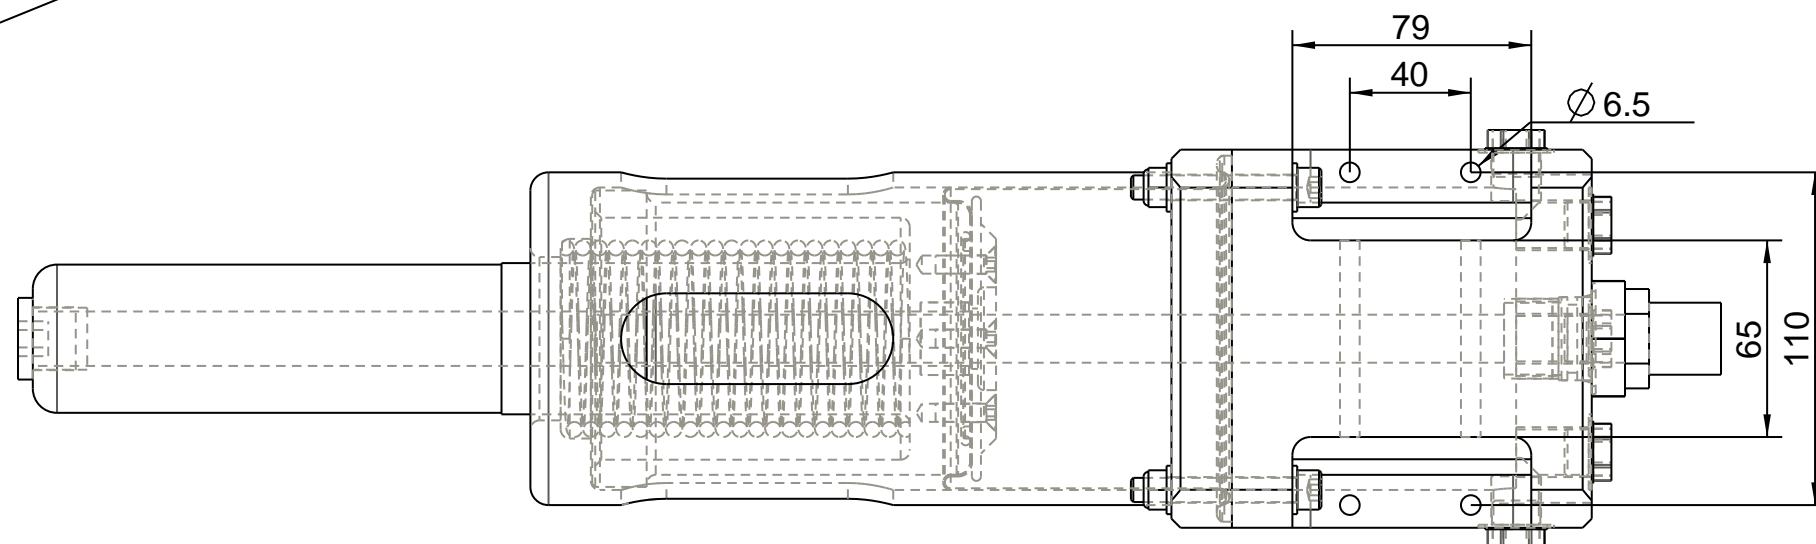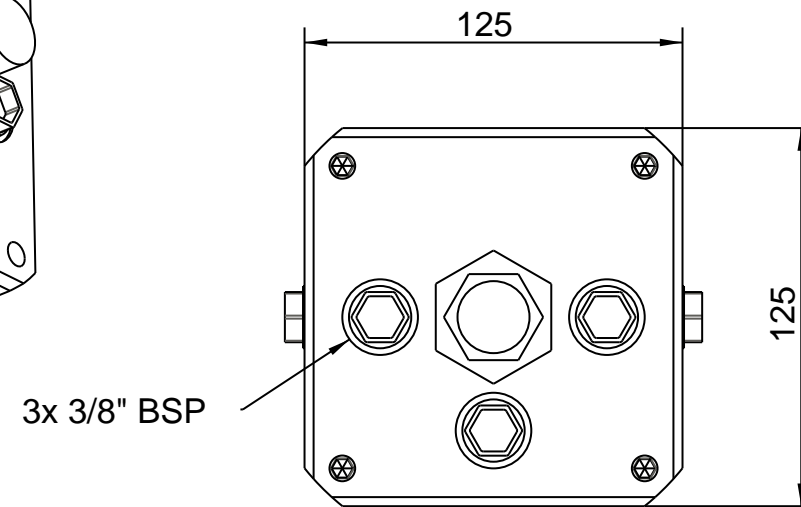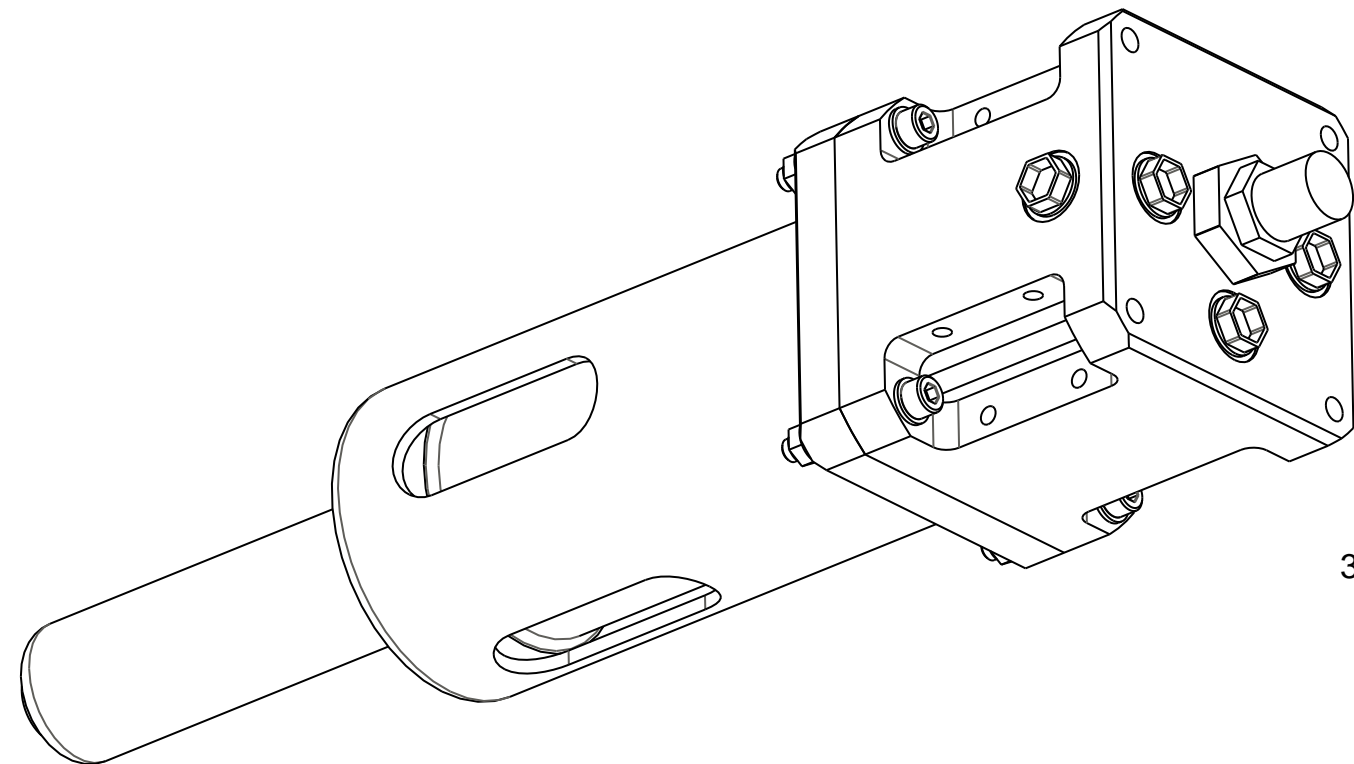

Itm.	Qty.	Description	Drg. / Spec.	Material	
02	23.04.02	AS BUILT	GVI	AHO	PGE
01	28.11.01	ISSUED FOR PRODUCTION	GVI	AHO	PGE
A	24.08.01	ISSUED FOR COMMENTS	AHO	EKB	PGE
Rev.	Date	Description	Prep	Chk	App



Drawing title Compensator - 1,2 litre Assembly -		 Size A3
KYSTDESIGN AS Strandgaten 202, 5525 Haugesund, NORWAY Tel: +47 52 70 62 50 Fax: +47 52 70 62 01 www.kystdesign.no	Scale 2:5	Sheet 2
	File name AB89-1037M01	of 2