

A

A

B

B

C

C

D


D

E

E

Drawing sheet size A3

F

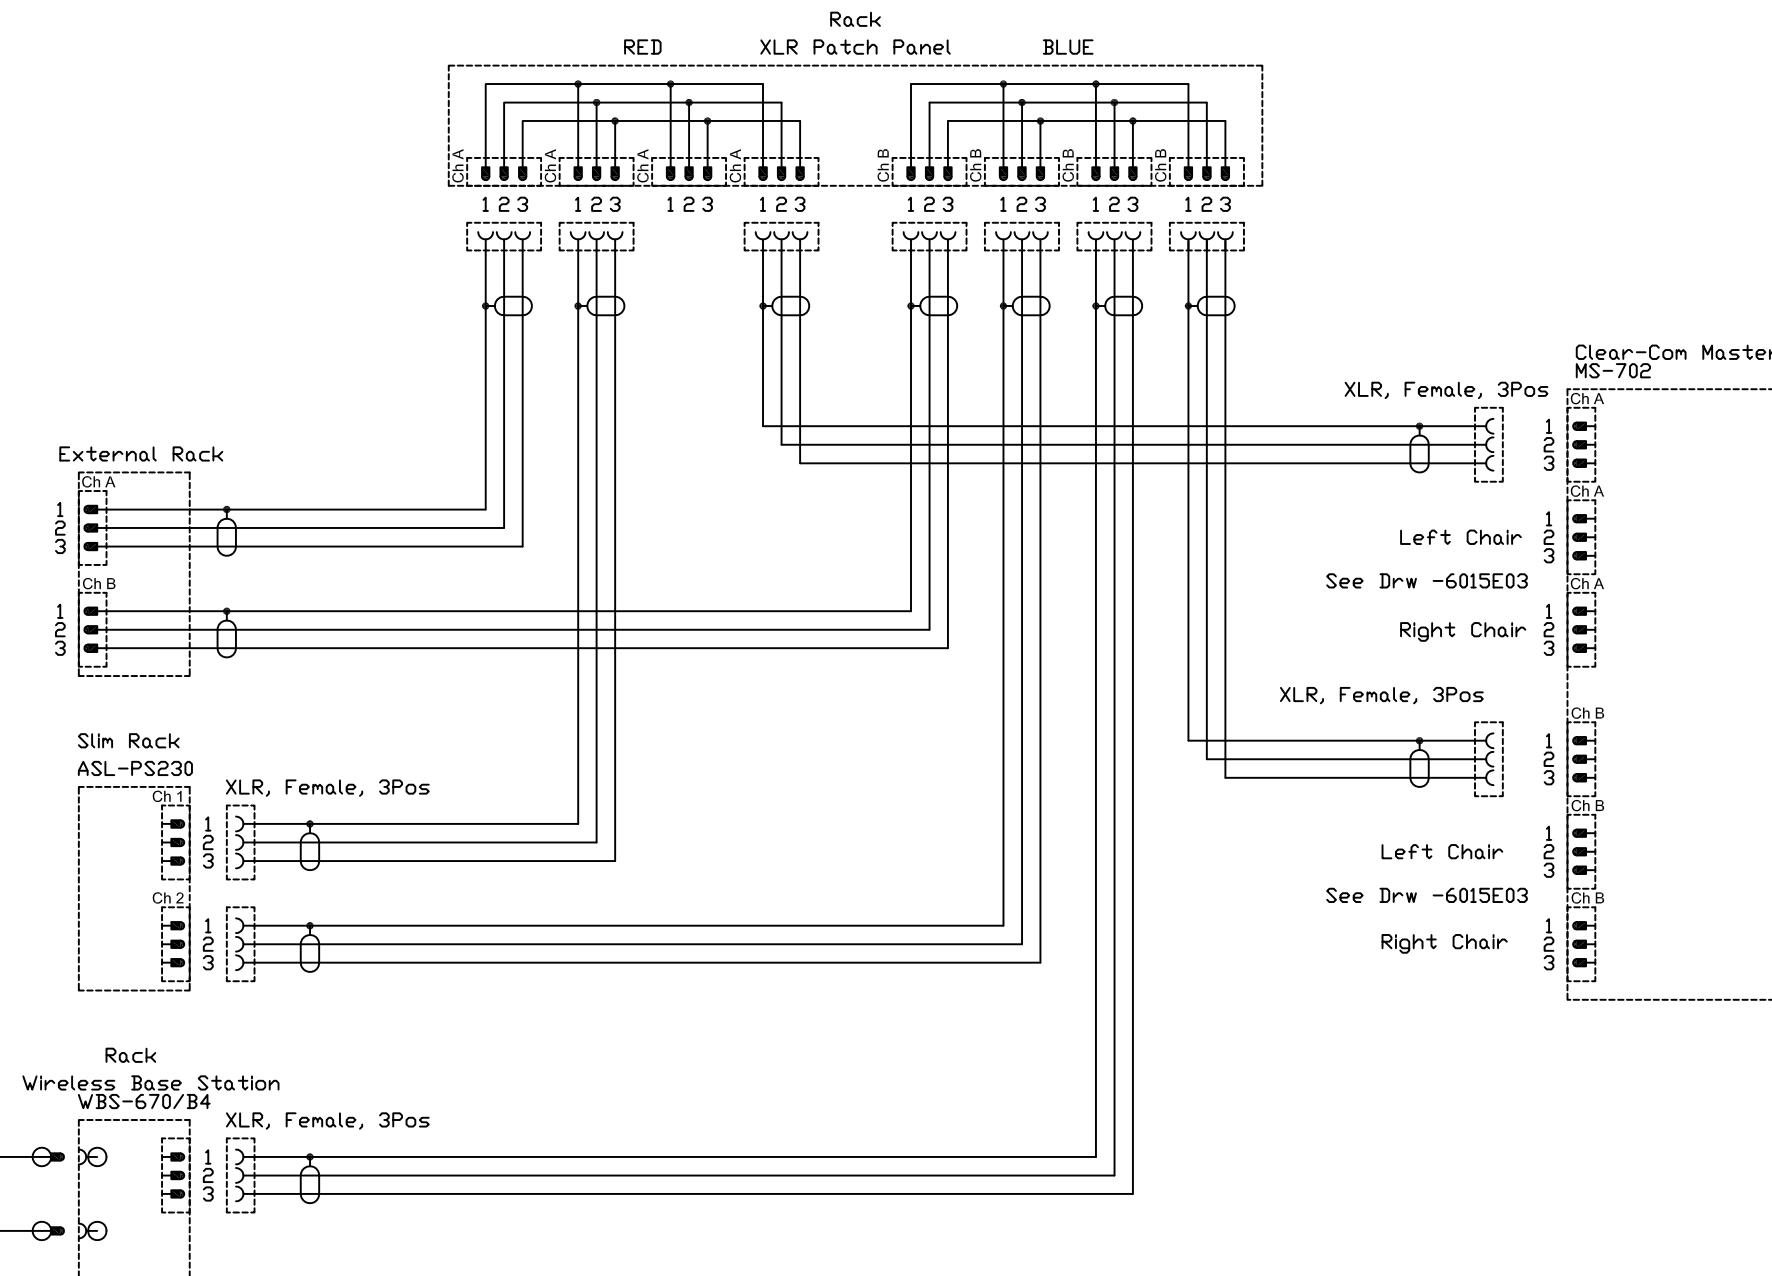

Item	Pty.	Description	Manufacturer	Part Number
Vendor name, number & logo				
<b>KYSTDESIGN AS</b>				
Strandgaten 202, 5525 Haugesund Tel: +47 52 70 62 50 Fax: +47 52 70 62 01 web: www.kystdesign.no				
01	18.03.15	AS BUILT	KST	TBH
Rev.	Date	Issue	Prepared by	Checked by
			By Originator	InterApproved
			Engineering Check	Engineering Approval
			Project Approved	Customer Approval
Document Title				
<b>Clear-Com</b>				
Sheet N°: 1 of 1				
KYSTDESIGN AS Drawing No. AF58-3-6021E15				
Scale		A3 - NA	Revision	01