


Do not connect the ROV Ethernet to any outside network. This to avoid network conflicts and system failures.
The Ethernet cables and the RJ45 plugs must be completely shielded. If not electric noise from e.g. winches may disturb the system links.
This especially applies to external network cables. Use shielded bulkheads, plugs and cables. Use Fibre if distance > 100m.

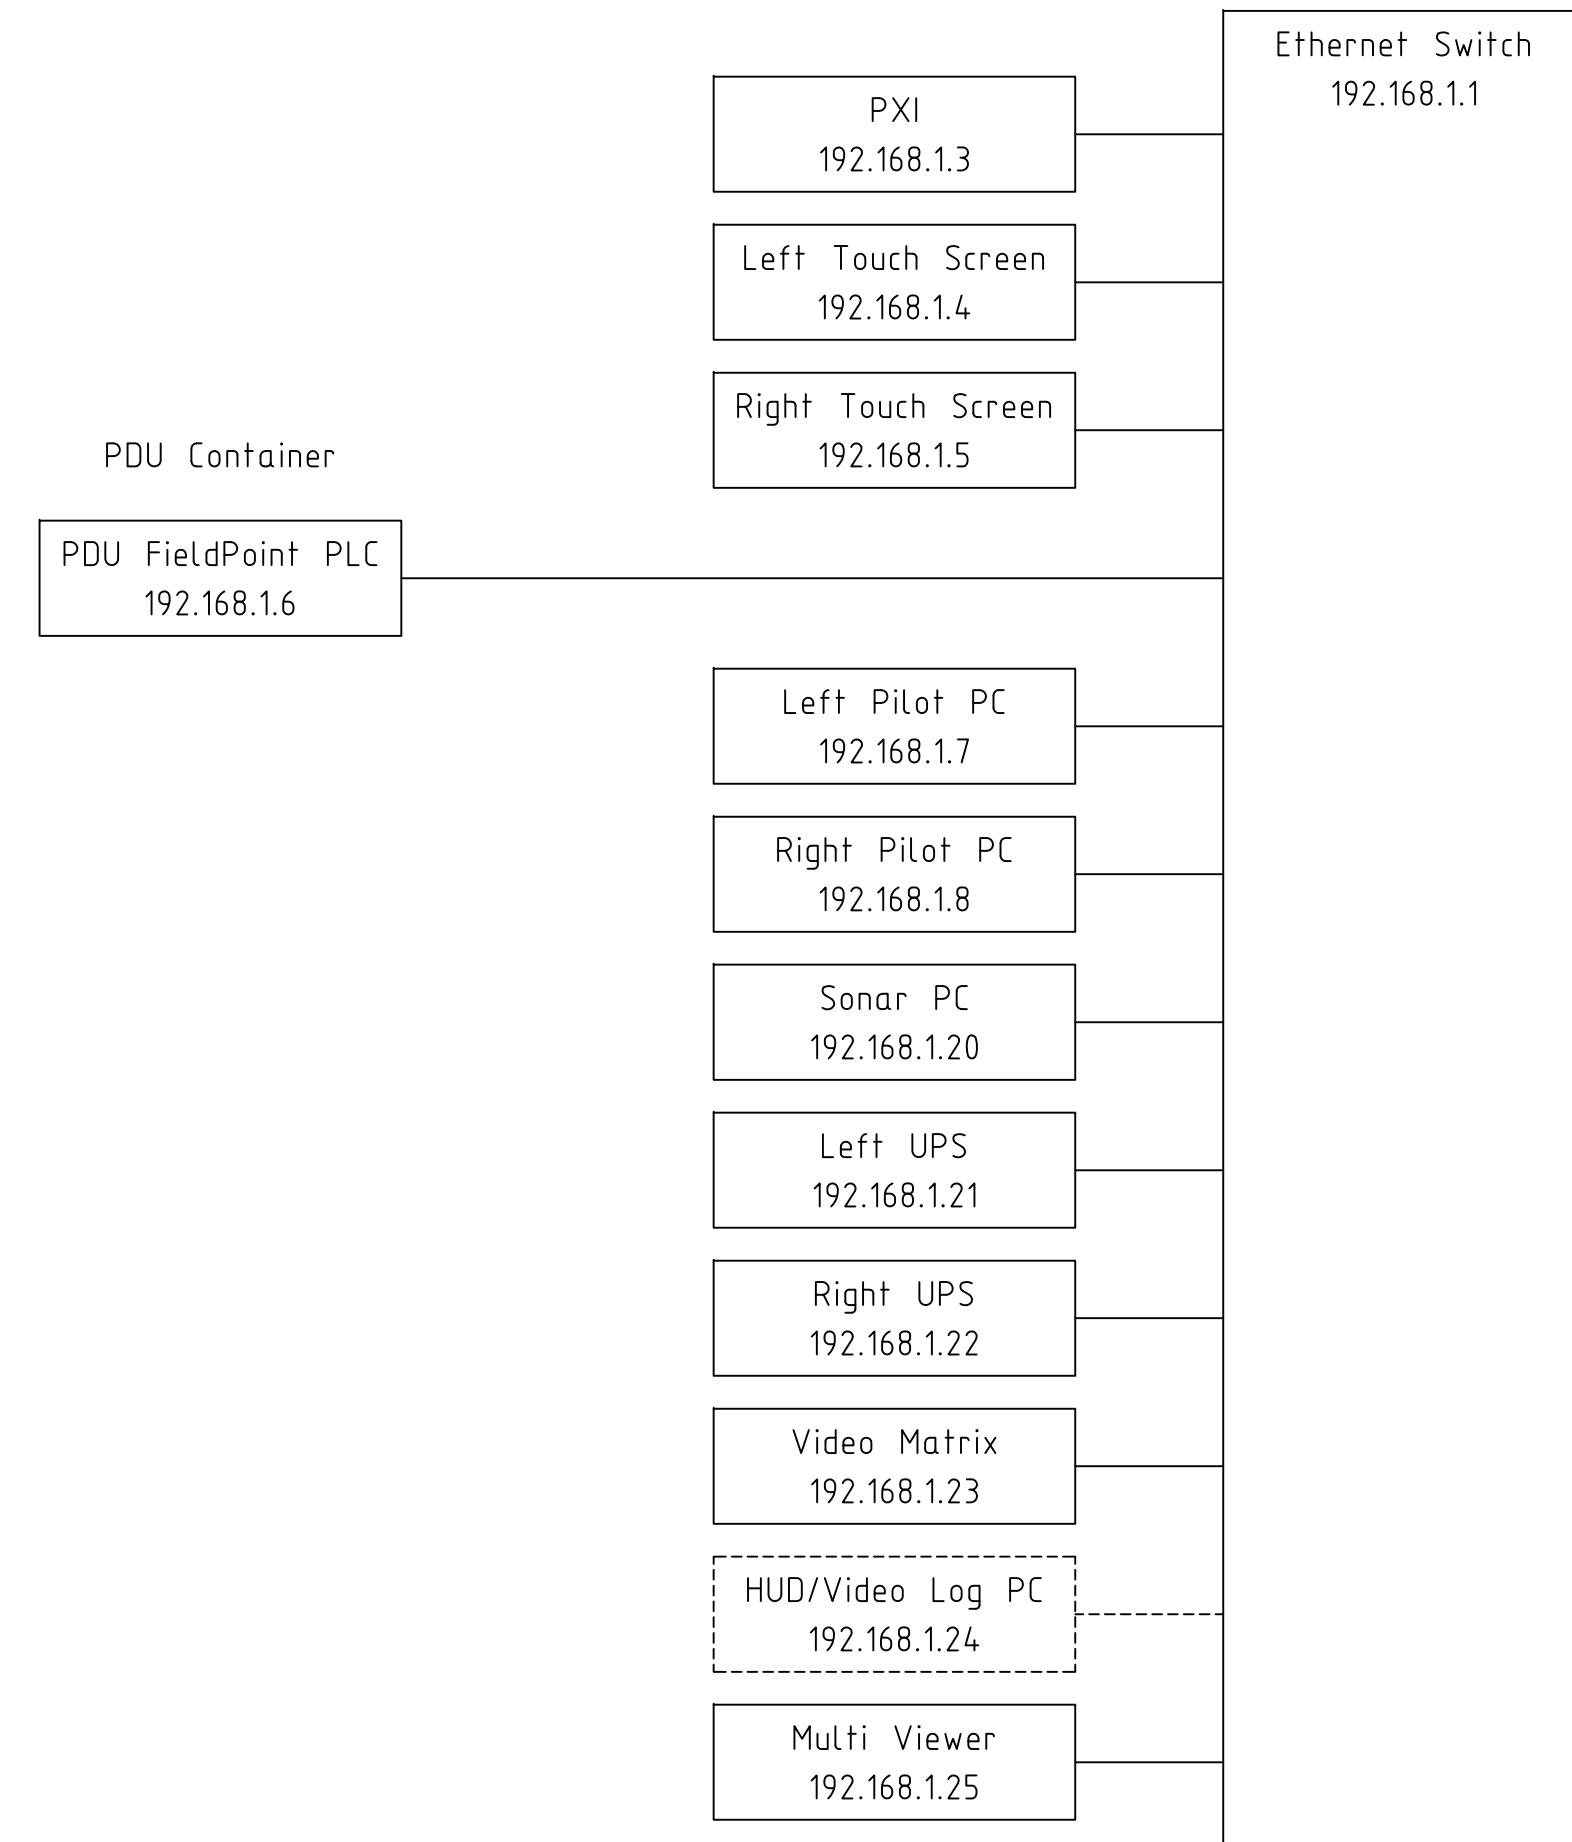

Item	Oty.	Description	Manufacturer	Part Number				
Vendor name, number & logo KYSTDESIGN AS			Strandgaten 202, 5525 Haugesund Tel: +47 52 70 62 50 Fax: +47 52 70 62 01 web: www.kystdesign.no					
01	09.12.2013	AS BUILT	KST Prepared by By Originator	TBH Checked by InterApproval	EKB Engineering Check			
Rev.	Date	Issue				Engineering Approval	Project Approval	Customer Approval
Document Title CONTROL CONTAINER Ethernet Routing								
							Sheet N: 1 of 1	
							Scale	Revision
							A3 - NA	01
KYSTDESIGN AS Drawing No. AF38-6021E10								