

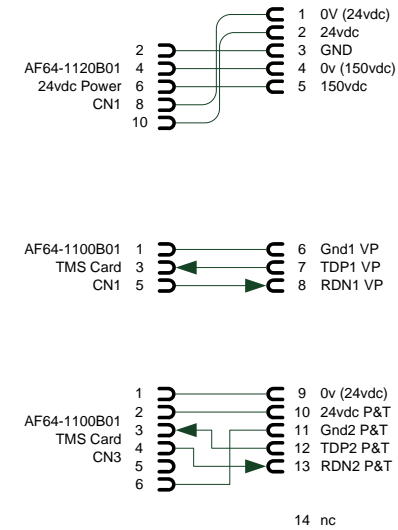
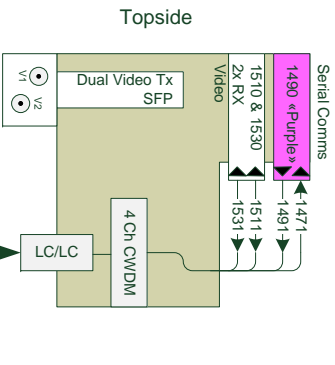


TMS Subsea Controller

Warning!
150VDC

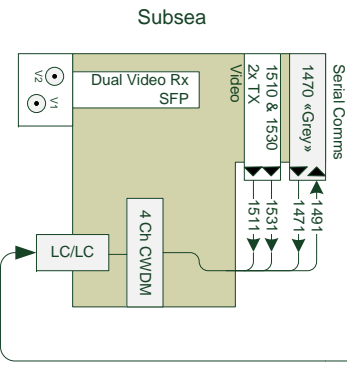



See Drw 1110E01/-02/-03

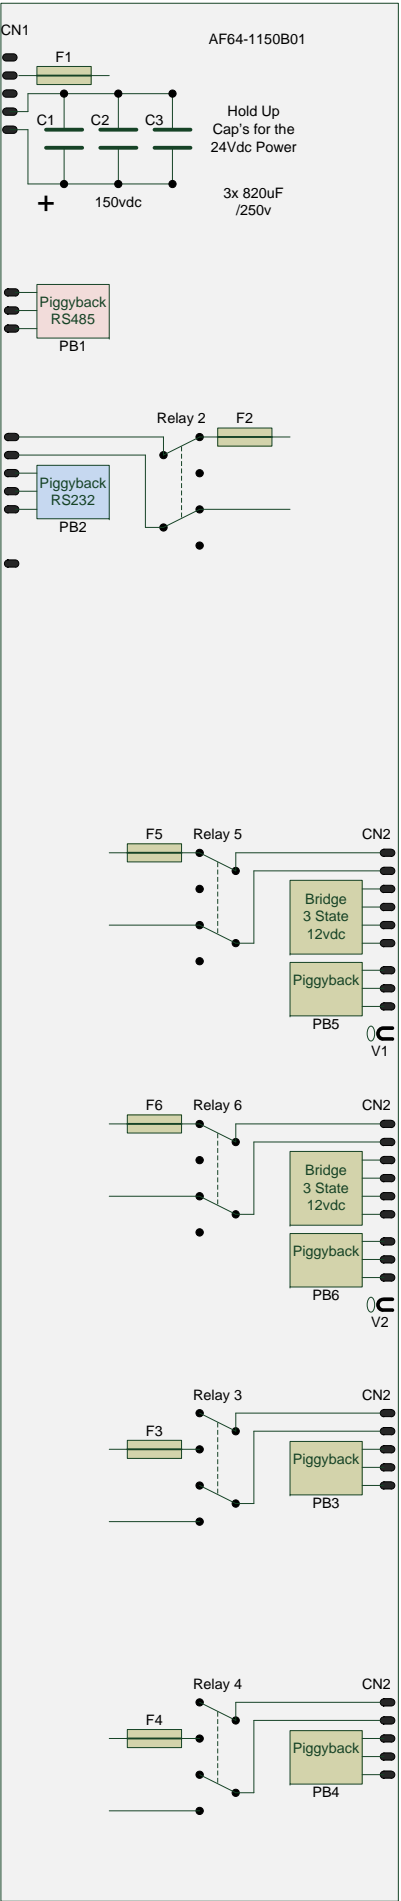

Fibre

1 Camera 1

Min-L 1 Coax/6 electric

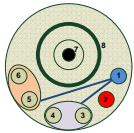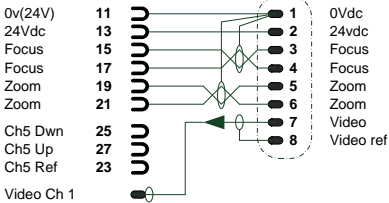

REV 01	DATE 18 03 2016	DESCRIPTION As Built	DRAWN BY KST	APPROVED EKB
			DESCRIPTION	
TMS El. Pod Wiring Diagram			SIZE A3	SHEET 6
			OF 1	REVISION 1
KYSTDESIGN AS Strandgaten 202, 5525 Haugesund NORWAY Tel +47 52 70 62 50 Fax +47 52 70 62 01 www.kystdesign.no		SHEET NAME POD	DRAWING FILE NAME AF64-10-2-1150E01	