


The UPSs do have Web servers which can configure the UPSs settings. Use Windows Internet Explorer to run the servers. Simply write the IP address in the Explorer address field. For the Left UPS write 192.168.1.21 and for the Right UPS write 192.168.1.22

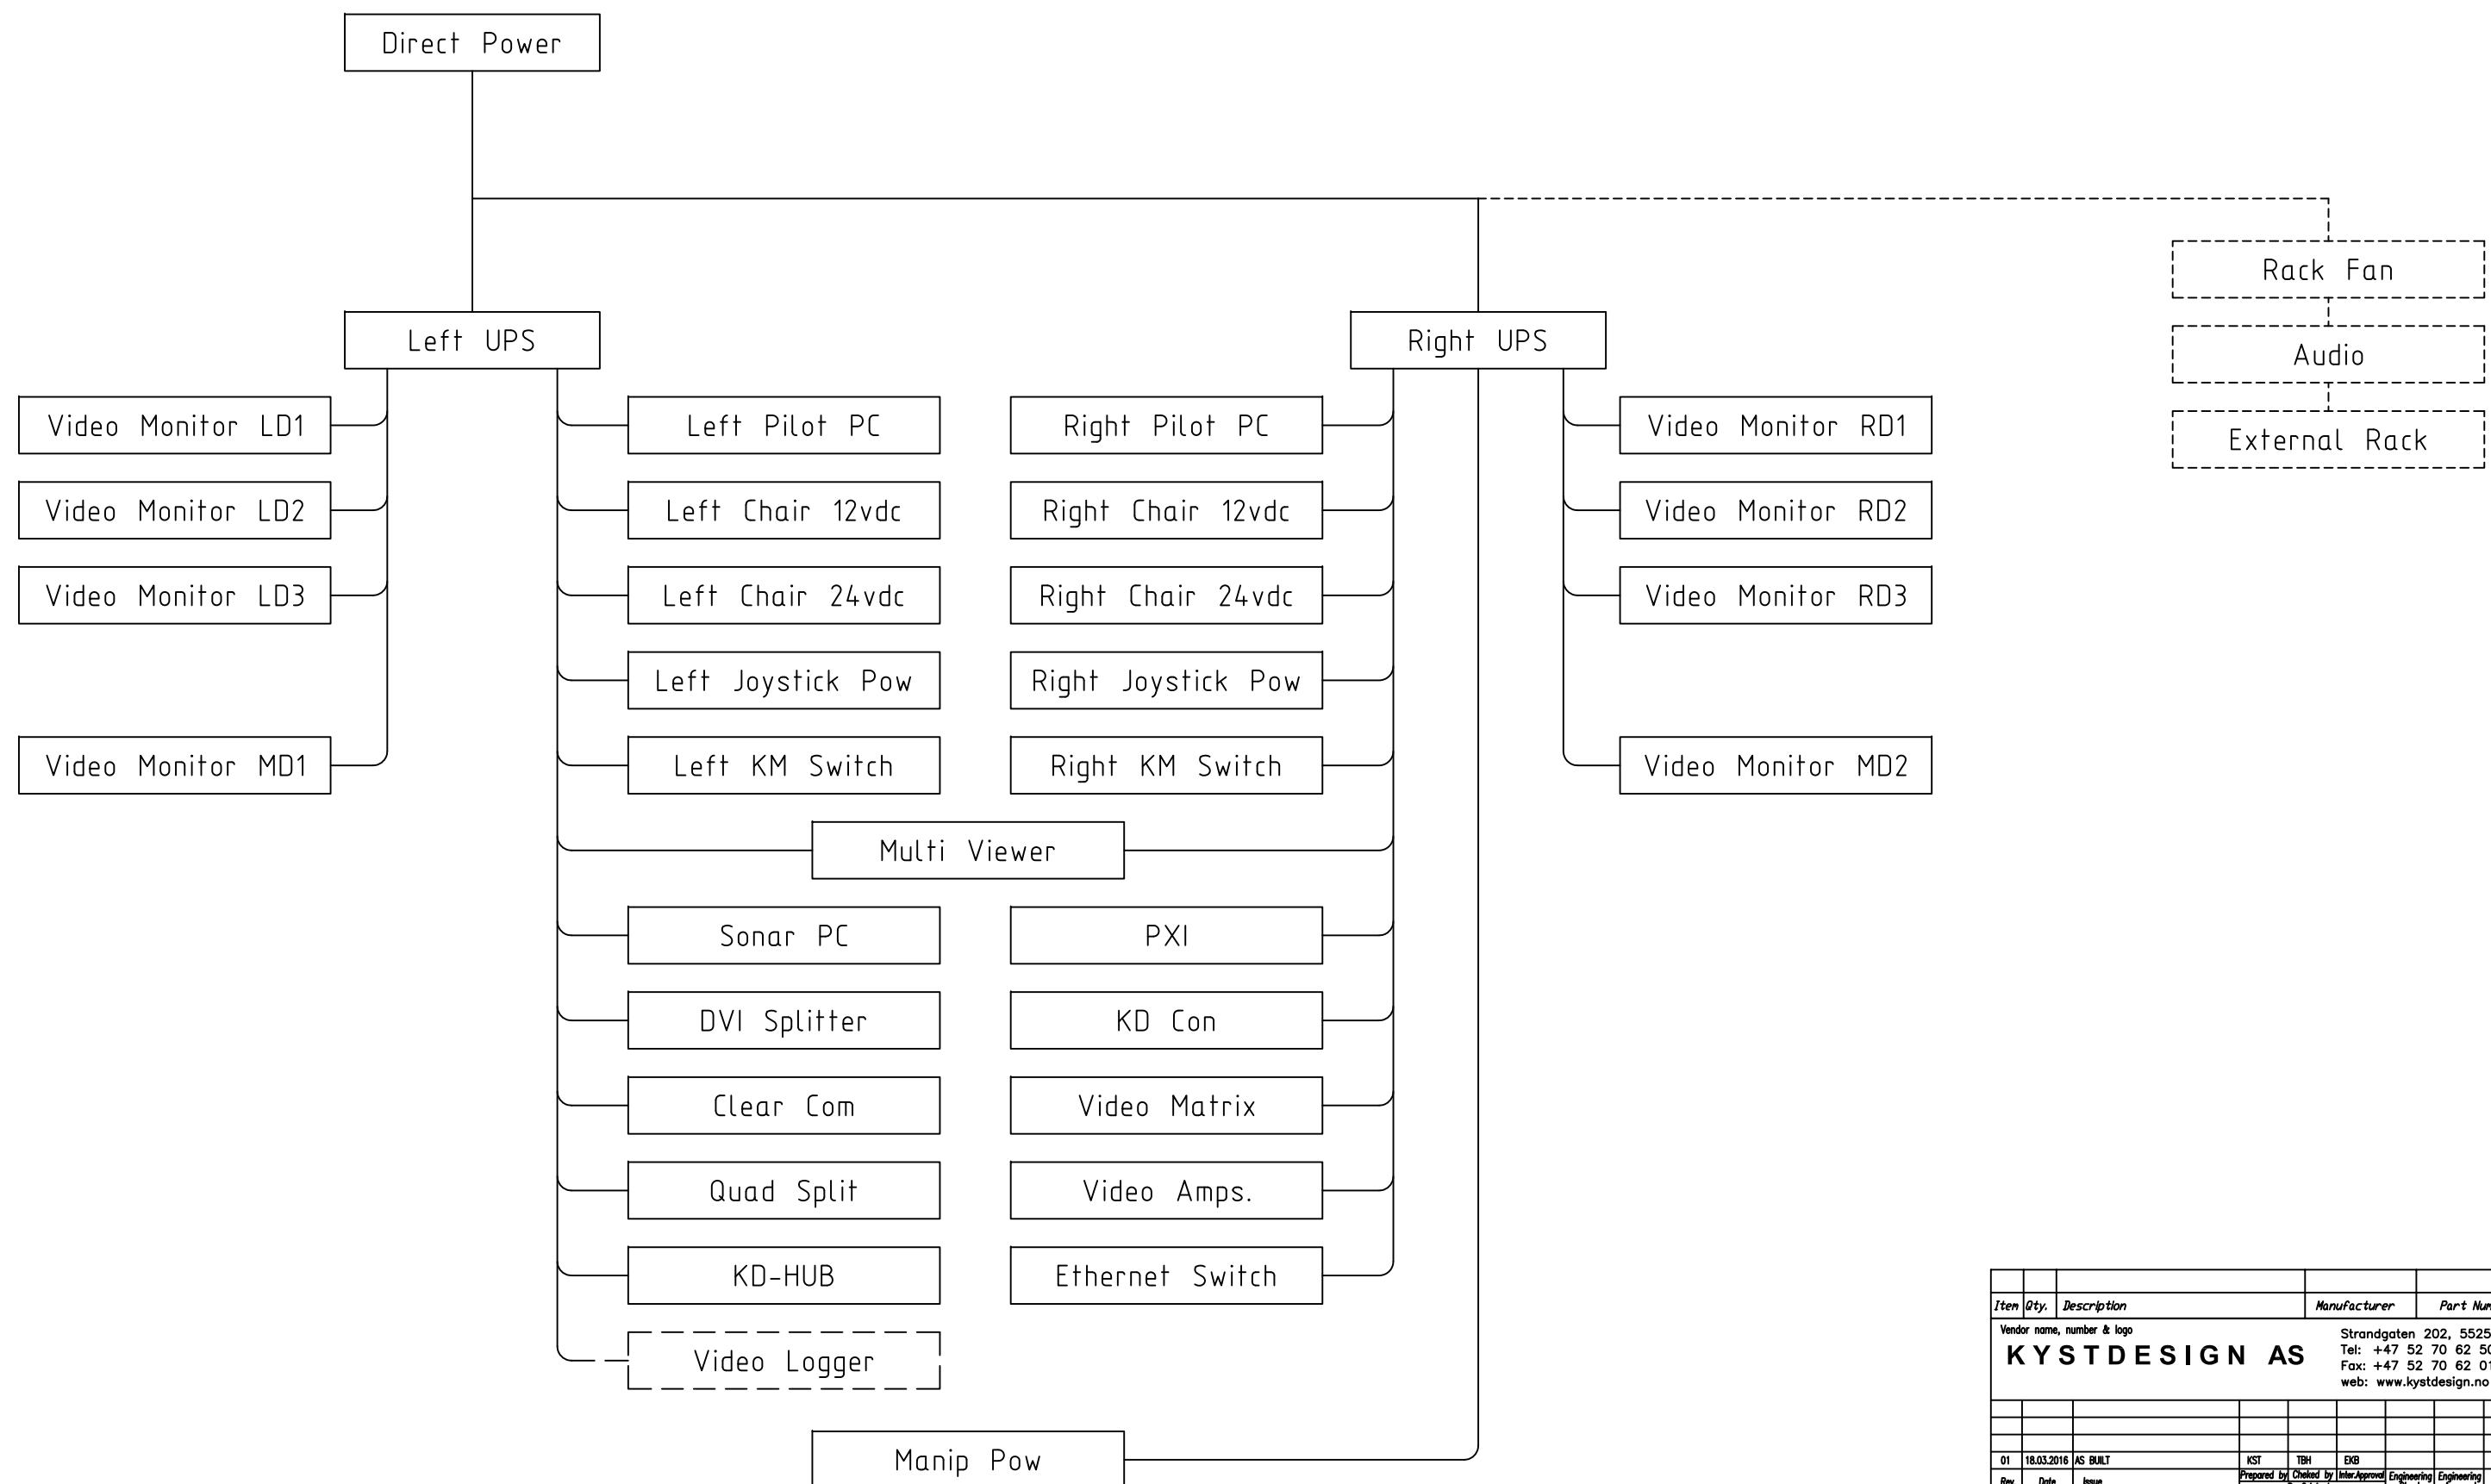

Item	Amt.	Description	Manufacturer	Part Number
Vendor name, number & logo				
KYSTDESIGN AS				
Strandgaten 202, 5525 Haugesund Tel: +47 52 70 62 50 Fax: +47 52 70 62 01 web: www.kystdesign.no				
01	18.03.2016	AS BUILT	KST	EBI
Rev.	Date	Issue	Prepared by	Checked by
			By Originator	InterApproved
			Engineering Check	Engineering Approval
			Project Approved	Customer Approval
Document Title CONTROL CONTAINER				
UPS Power Distribution				
Sheet N: 1 of 1				
KYSTDESIGN AS Drawing No. AF57-1-6021E05				Scale A3 - NA Revision 01