

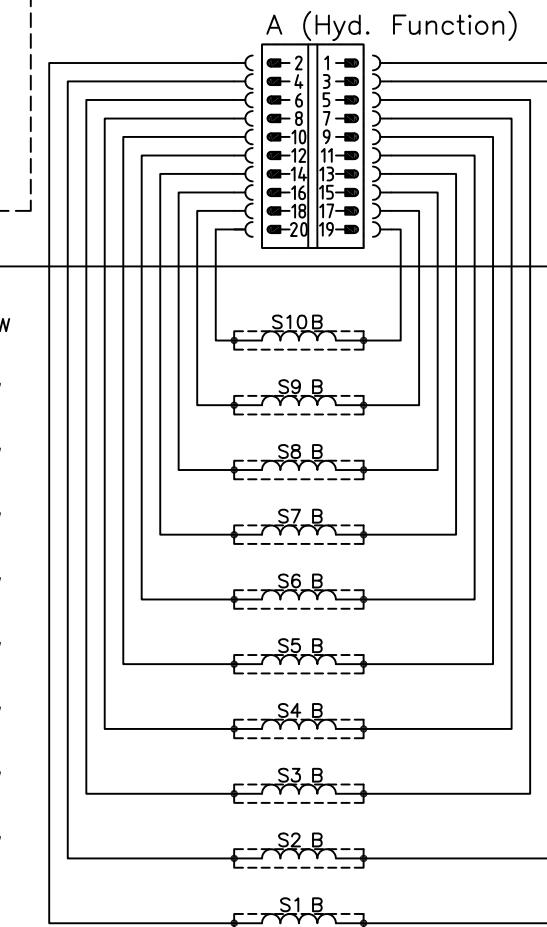
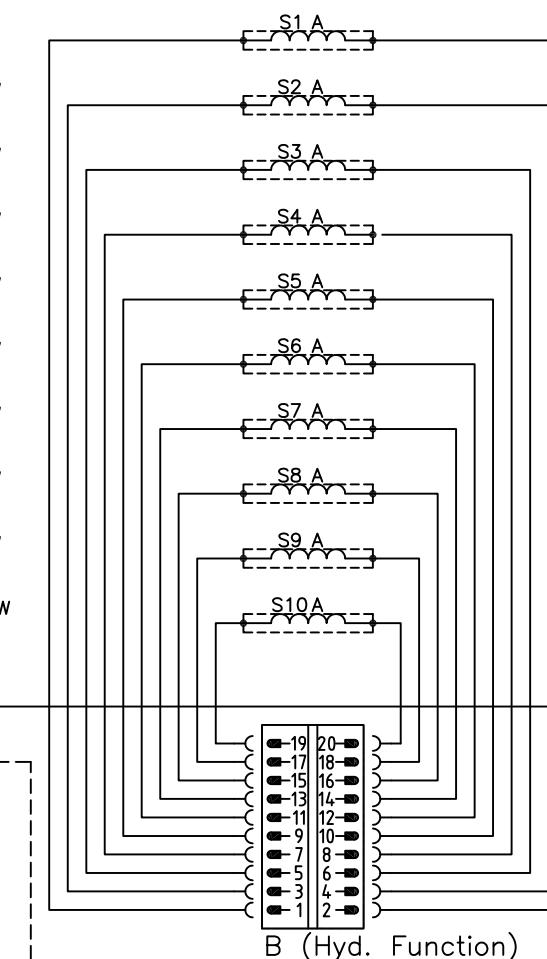




Function 1B Proportional Flow  
 Function 2B Proportional Flow  
 Function 3B Proportional Flow  
 Function 4B Proportional Flow  
 Function 5B Proportional Flow  
 Function 6B Proportional Flow  
 Function 7B Proportional Flow  
 Function 8B Proportional Flow  
 Function 9B Proportional Flow  
 Function 10B Proportional Flow

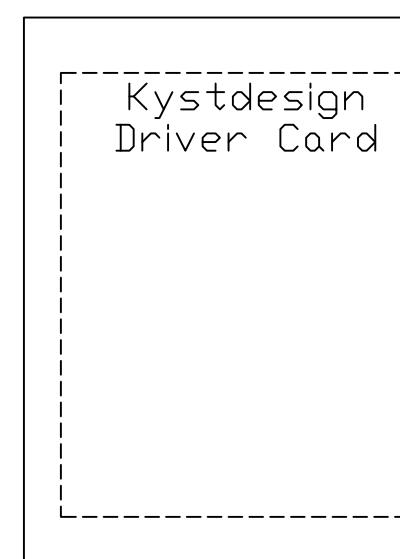

Function 10A Proportional Flow  
 Function 9A Proportional Flow  
 Function 8A Proportional Flow  
 Function 7A Proportional Flow  
 Function 6A Proportional Flow  
 Function 5A Proportional Flow  
 Function 4A Proportional Flow  
 Function 3A Proportional Flow  
 Function 2A Proportional Flow  
 Function 1A Proportional Flow

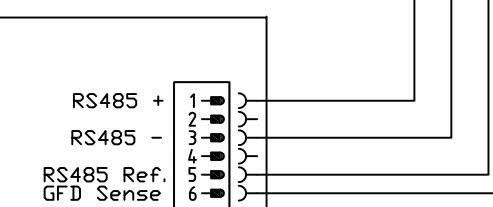

GFVP TERM./LED CARD

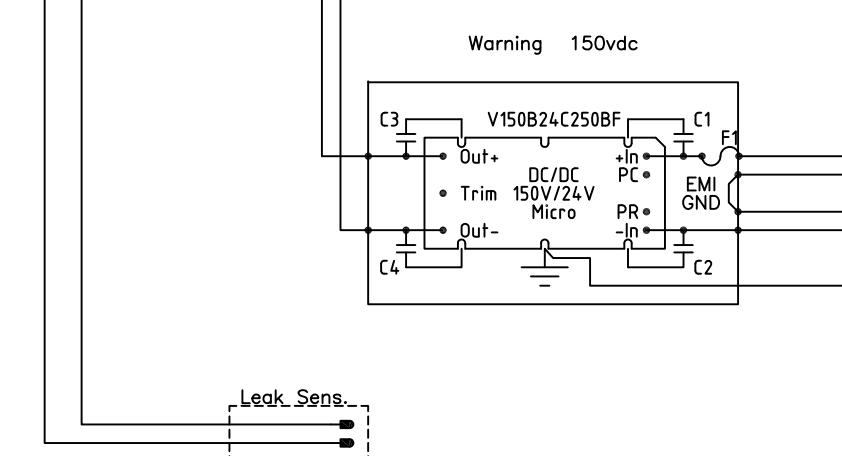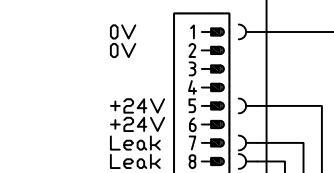

Item	Qty.	Description	Manufacturer	Part Number
<b>KYSTDESIGN AS</b>				
Vendor name, number & logo			Strandgaten 202, 5525 Haugesund	
			Tel: +47 52 70 62 50	
			Fax: +47 52 70 62 01	
			web: www.kystdesign.no	
02	04.06.2013	AS BUILT	EAP	
Rev.	Date	Issue	KST	EWB
			Prepared by	Checked by
			By Originator	InterApproved
			Engineering Check	Engineering Approval
			Project Approved	Customer Approval
Document Title				
<b>ROV</b>				
GFVP Wire Diagram				
Sheet N°: 1 of 1				
KYSTDESIGN AS Drawing No. AF25-1035E01				Revision 02
Scale A3 - NA		Revision 02		

