



1 | 2 | 3 | 4 | 5 | 6 | 7 | 8

A

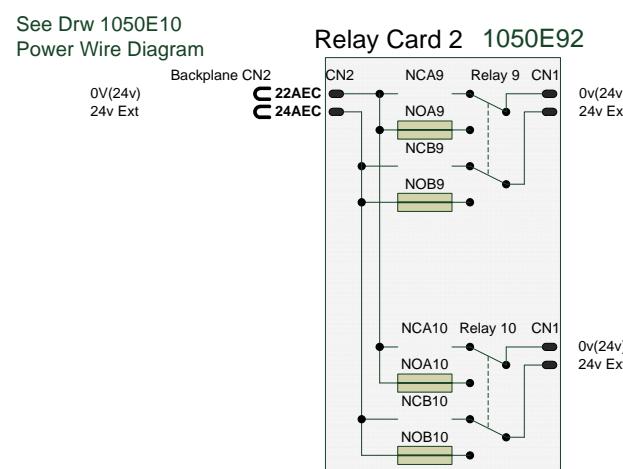


Backplane CN9

Serial Card 3 1050E95

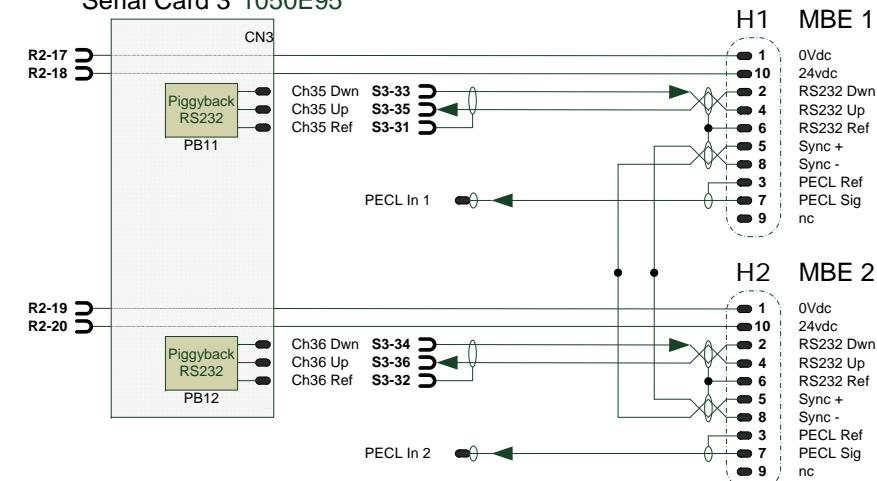

Min-K 2#14,8#20

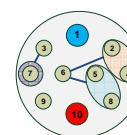

B

C

D

E

F

G

H

A

B

C


D

E

F


G

H

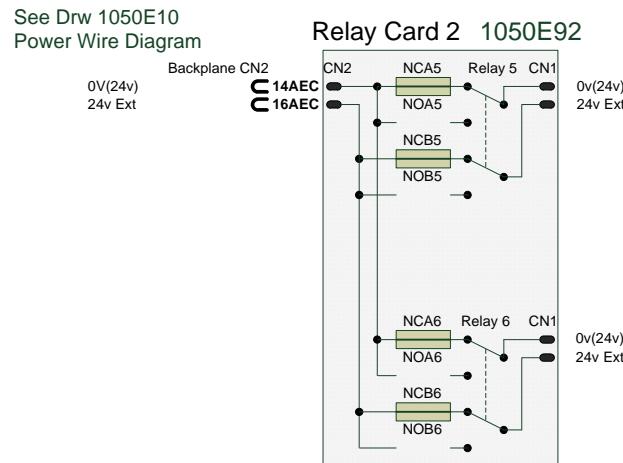


Backplane CN9

Serial Card 2 1050E95

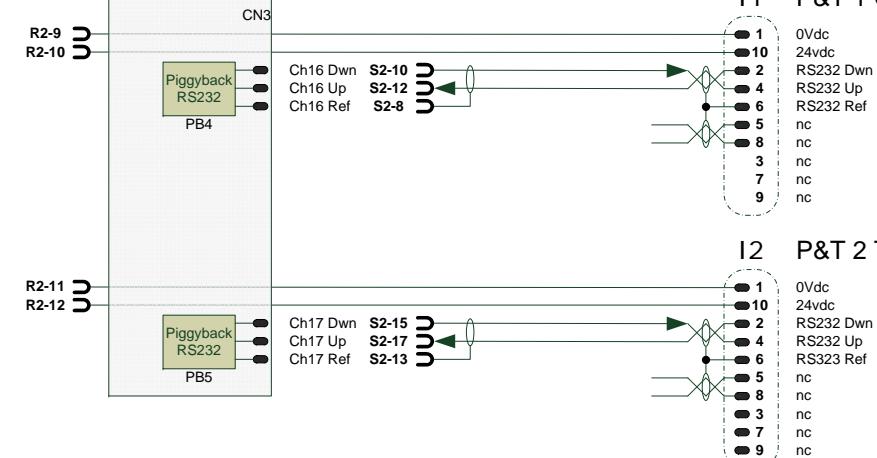

Min-K 2#14,8#20

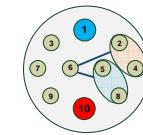

Rev	Date	Issue	Prep. by	Ch. by	Appr. by
C	22 09 15	Draft	KST	TBH	EKB
1	17 03 16	As Built	KST	TBH	EKB



Strandgaten 202, 5525
Haugesund NORWAY
Tel +47 52 70 62 50
Fax +47 52 70 62 01
www.kystdesign.no

Document Title		Constructor 5 & 6
Control Pod H1-2, I1-2 Wire Diagram		

Kystdesign AS Drawing No.

AF57-1-1050E23

SheetNo

1 of 1

Scale

A3

Revision

1

1 | 2 | 3 | 4 | 5 | 6 | 7 | 8