

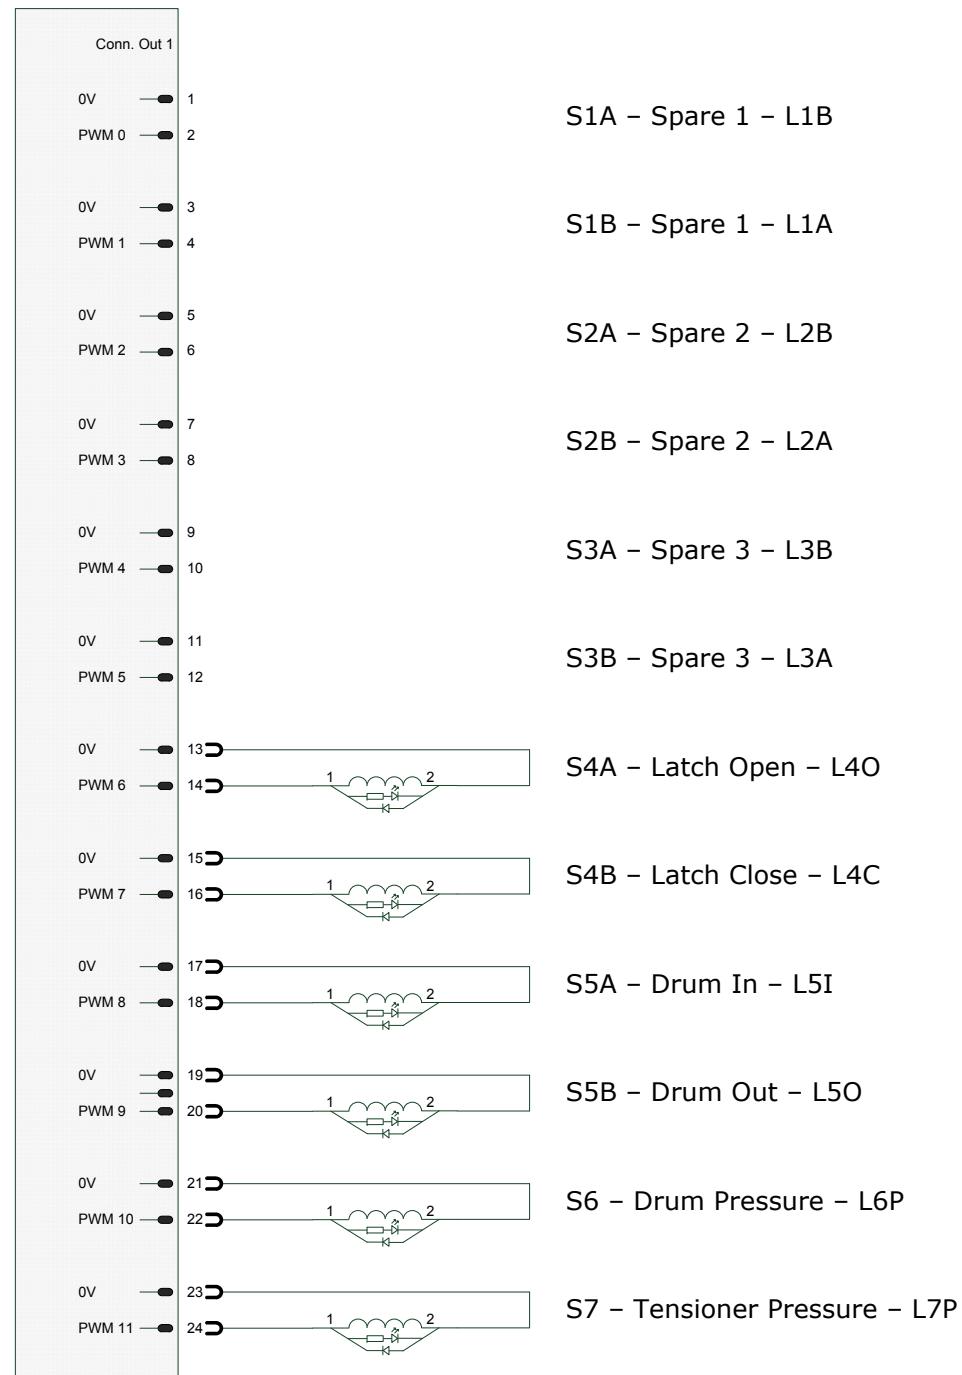


Termination Card

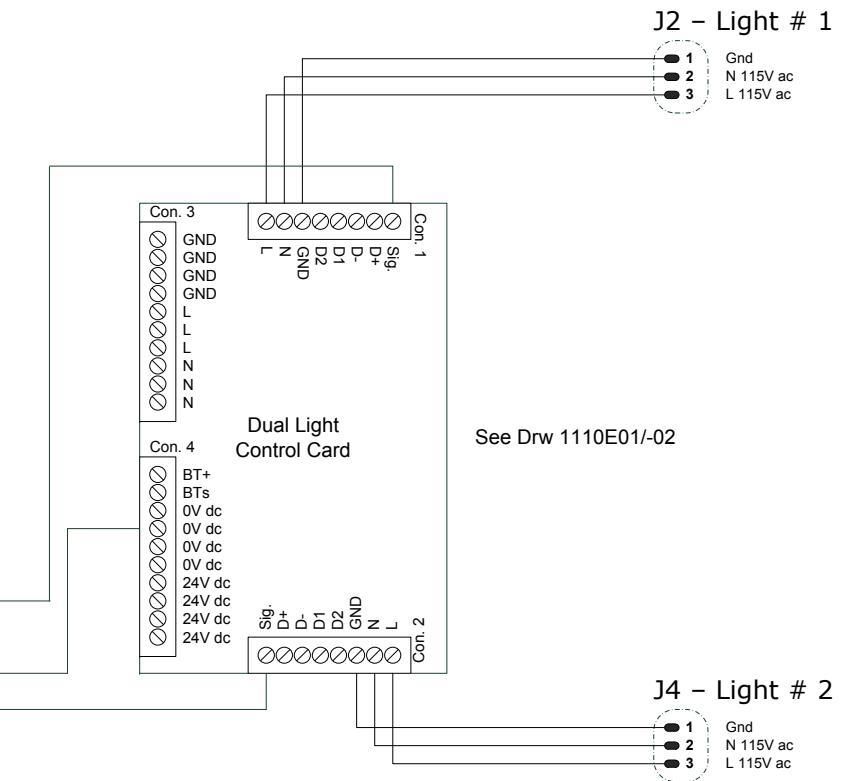

Termination Card

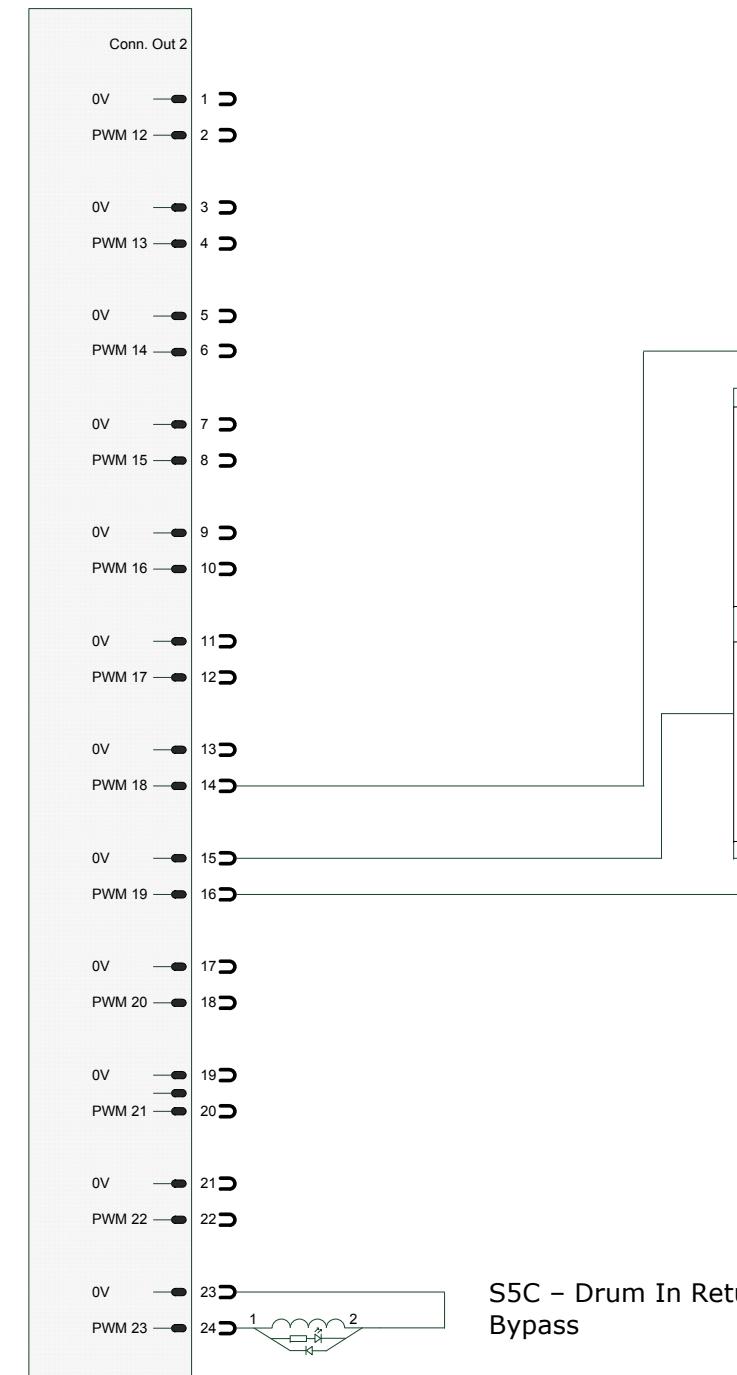

See Drw 1110E01/-02

REV	DATE	DESCRIPTION	DRAWN BY	APPROVED
01	18 03 2016	As Built	KST	EKB
02	03 05 2019	Added Drum In Return Bypass Valve	KST	EKB

DESCRIPTION	SIZE
KD TMS Cabinet Wire Diagram	A3
	SHEET 1
KYSTDESIGN AS Strandgaten 202, 5525 Haugesund NORWAY Tel +47 52 70 62 50 Fax +47 52 70 62 01 www.kystdesign.no	OF 2
DRAWING FILE NAME AF64-10-2-1110E03	REVISION 2



KYSTDESIGN
SUB - SEA TECHNOLOGY