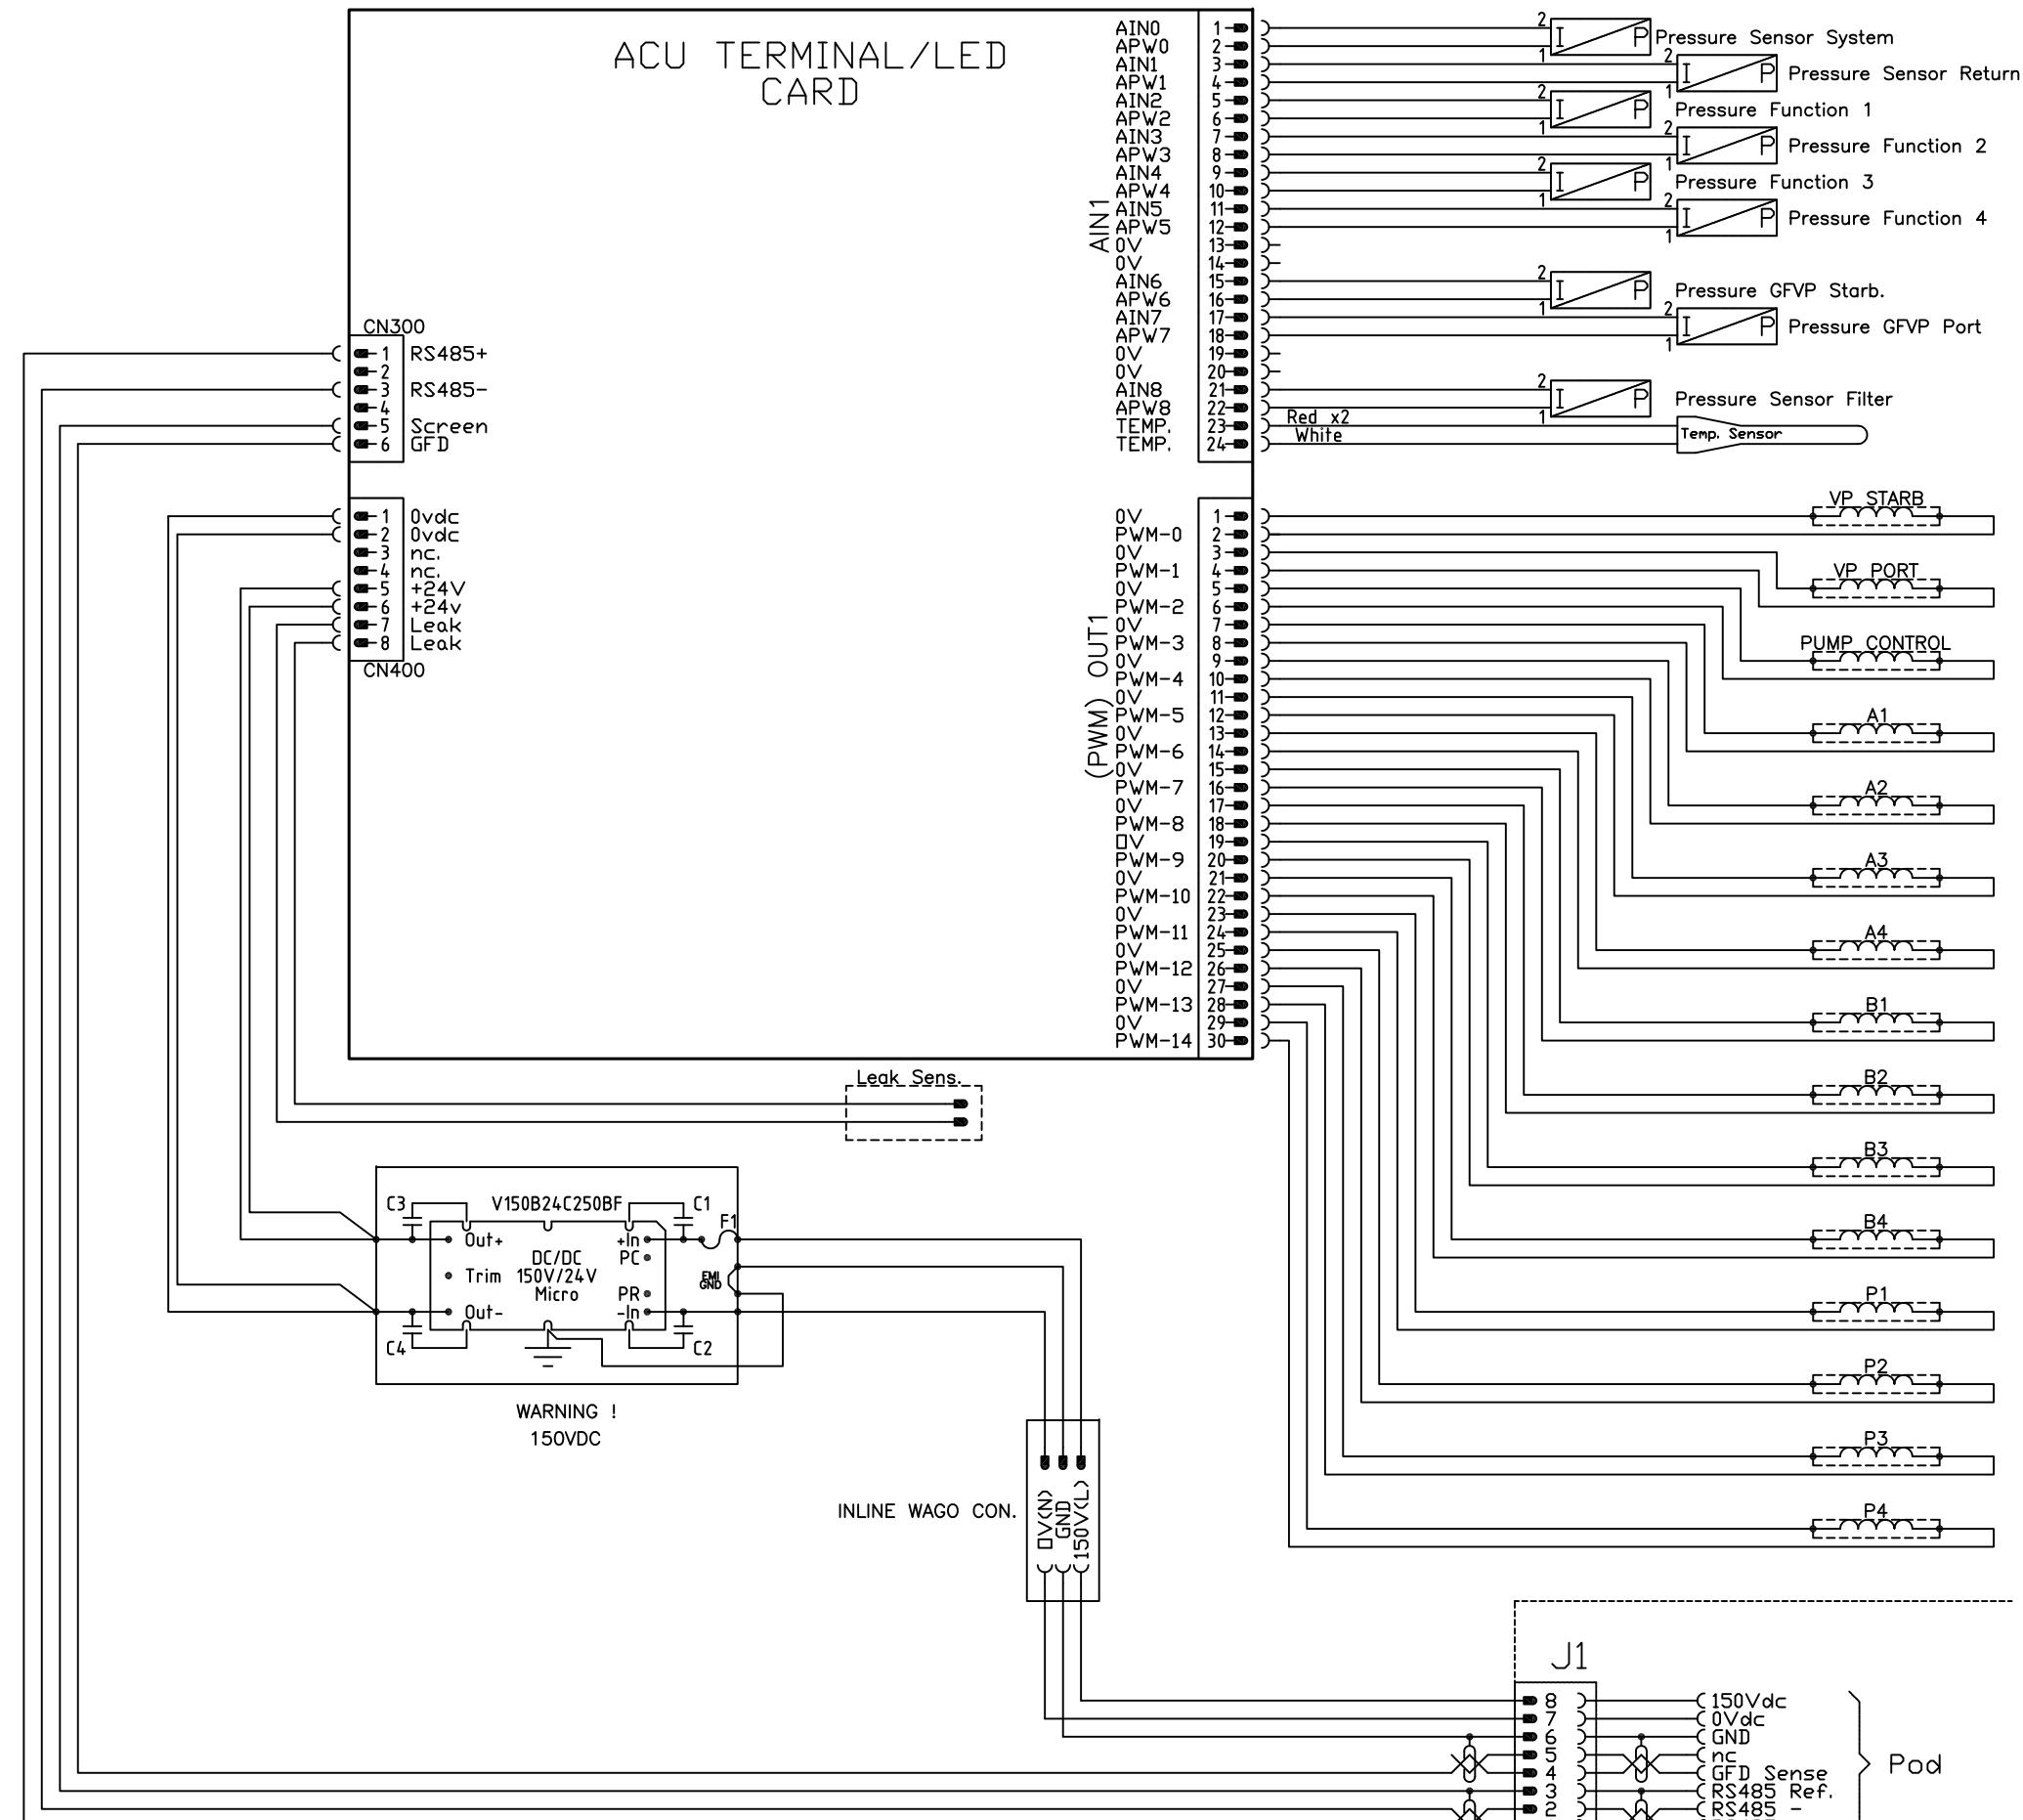


ACU TERMINAL/LED
CARD

Item	Qty.	Description	Manufacturer	Part Number
Vendor name, number & logo				
KYSTDESIGN AS				
Strandgaten 202, 5525 Haugesund				
Tel: +47 52 70 62 50				
Fax: +47 52 62 01				
web: www.kystdesign.no				
02	04.06.2013	AS BUILT	EAP	KST
Rev.	Date	Issue	Prepared by	Checked by
			By Originator	InterApproved
			Engineering Check	Engineering Approval
			Project Approval	Customer Approval
Document Title				
ROV ACU Wire Diagram				
Sheet N: 1 of 1				
KYSTDESIGN AS Drawing No. AF25-1034E01				Scale A3 - NA
				Revision 02