


Ref.	Date	Description	Drg. / Spec.	Material
03	24.08.16	New mat. Pos.201, new Pos.603	GVI	AHO EKB
02	26.08.15	AS BUILT	GVI	EAP EKB
01	22.05.14	AS BUILT	GVI	EAP EKB
A	01.07.13	ISSUED FOR COMMENTS	GVI	EAP EKB
Rev.	Date	Description	Prep	Chk App

 **KYSTDESIGN**
SUB-SEA TECHNOLOGY

Drawing title
Control Pod
General Arrangement

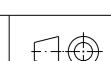


Size
A3

K Y S T D E S I G N A S
Strandgaten 202, 5525 Haugesund, NORWAY
Tel: +47 52 70 62 50
Fax: +47 52 70 62 01
www.kystdesign.no

Scale 1:5 Sheet 1
File name AD16-1150M01 of 6

In the information contained herein. Reproduction, use or disclosure to third parties without consent is strictly forbidden.
© KYSTDESIGN AS

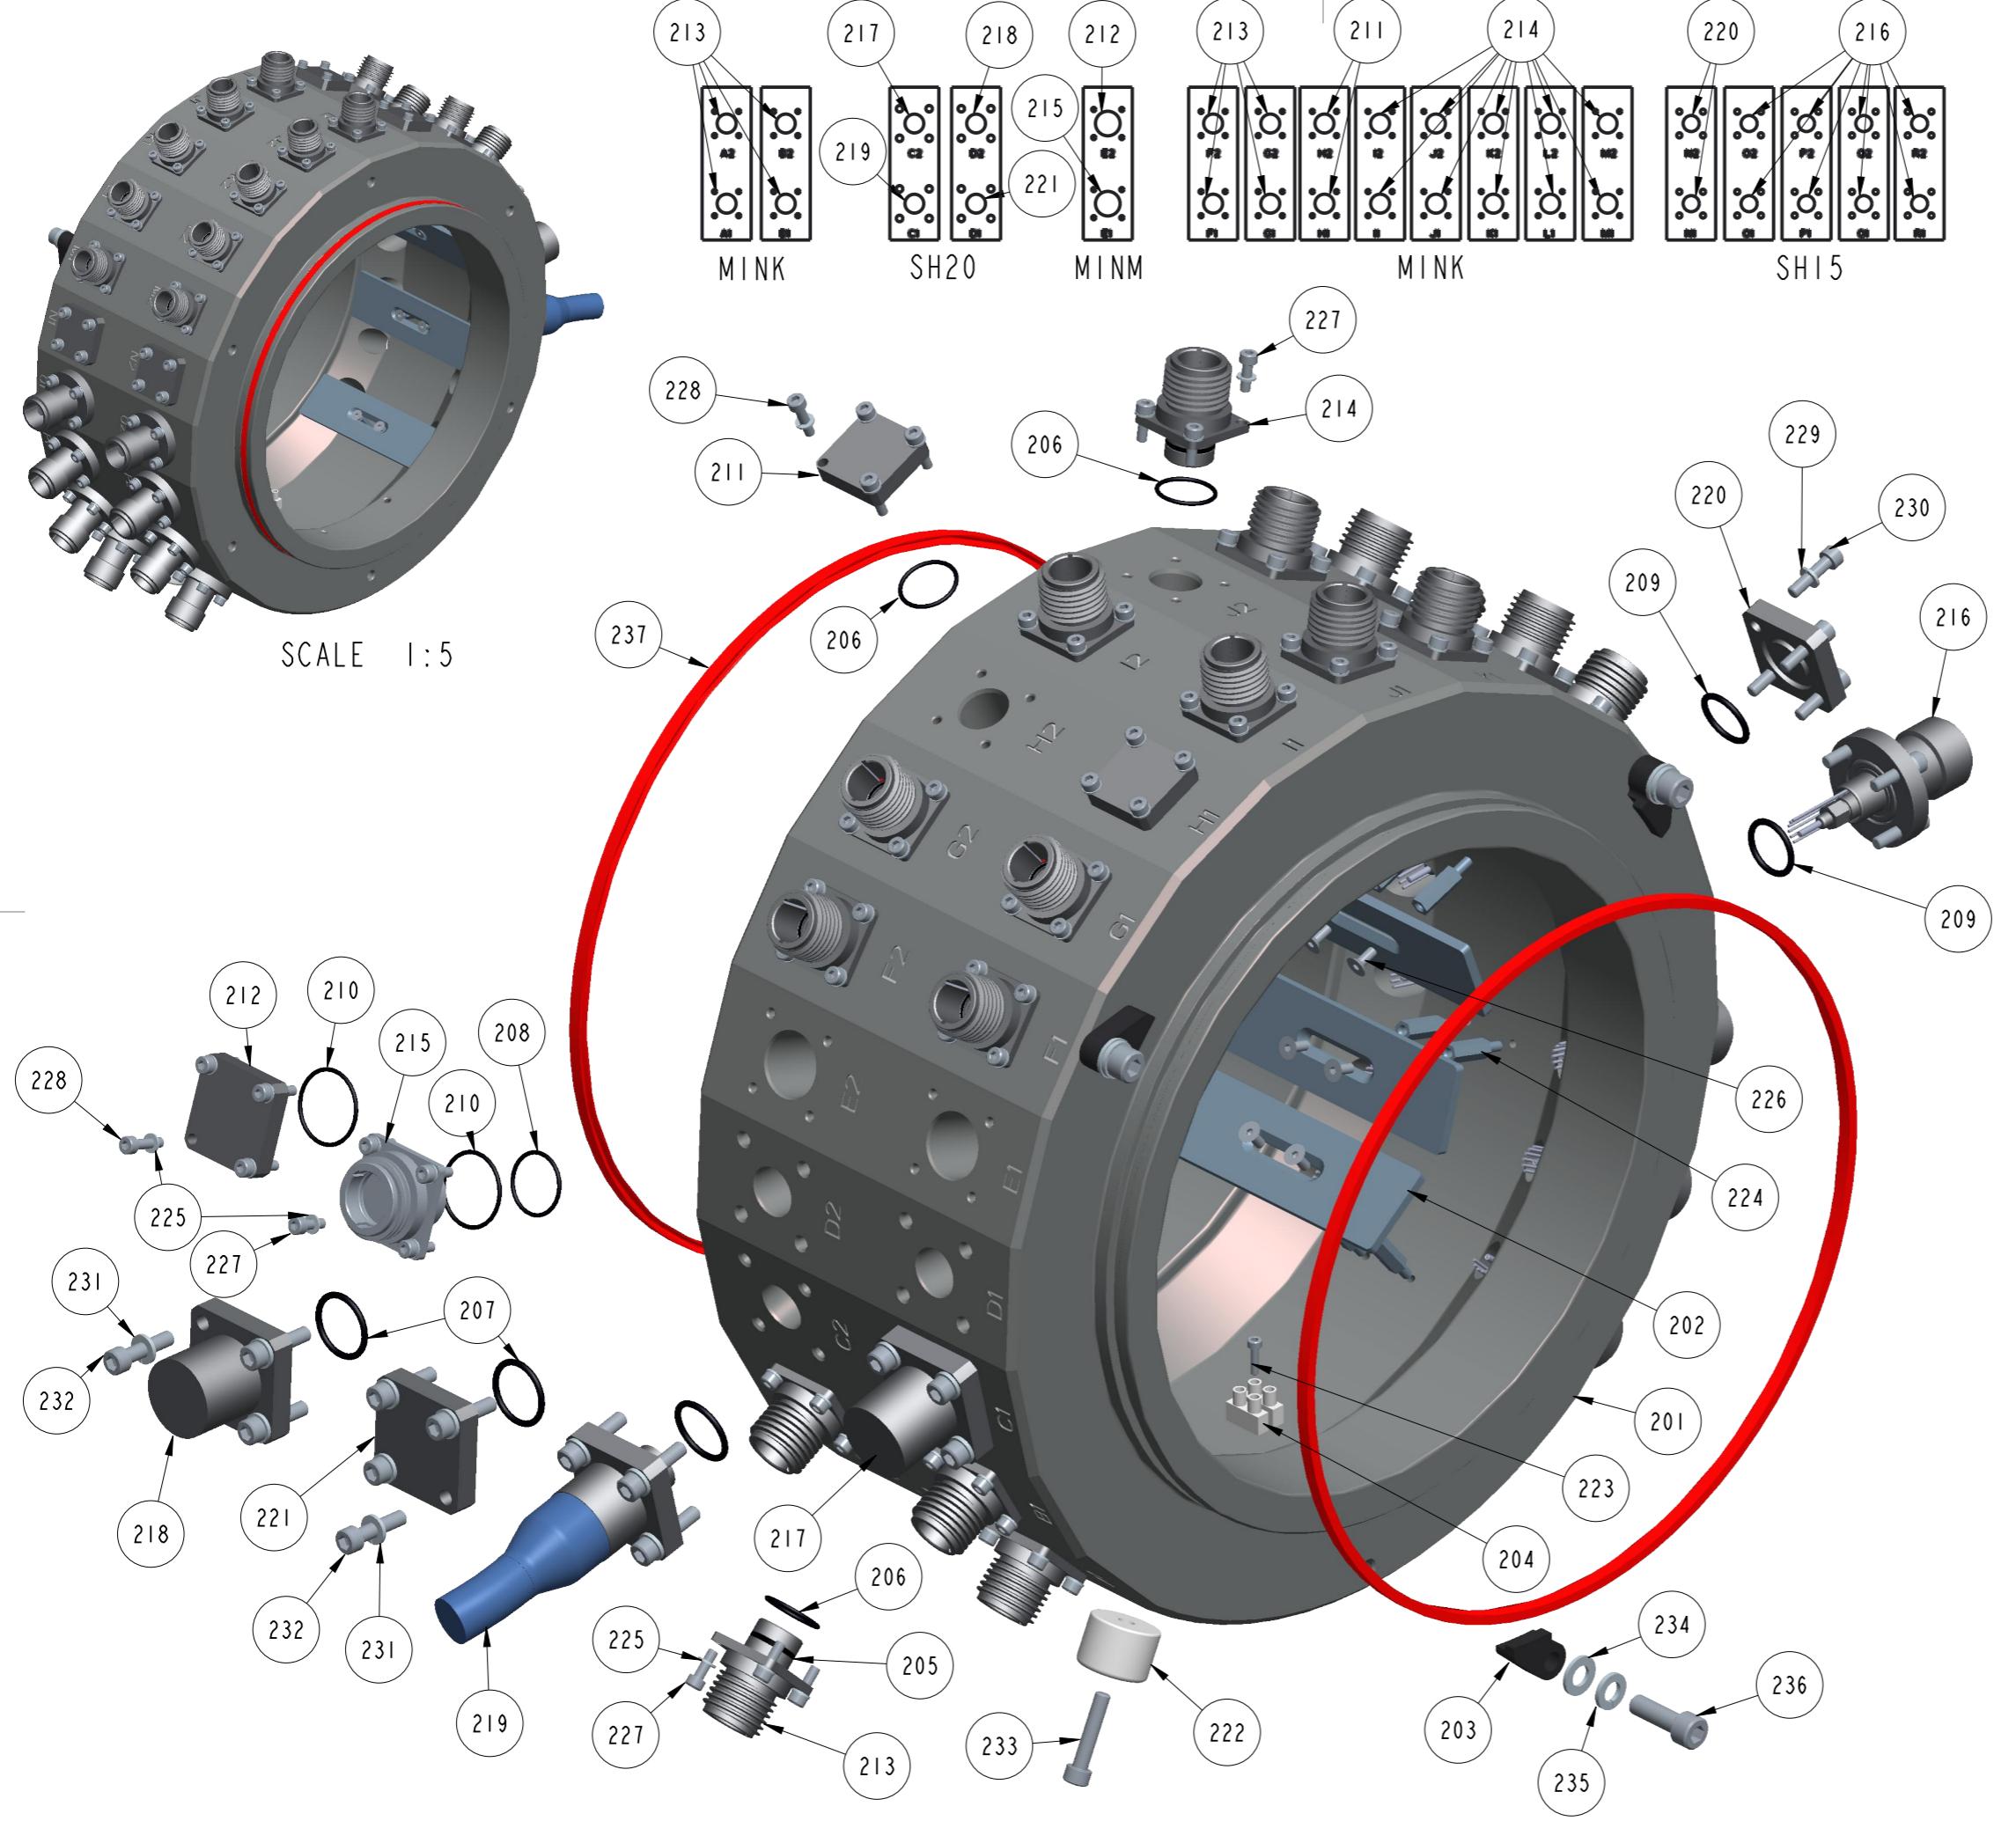

Itm.	Qty.	Description	Drg. / Spec.	Material
03	24.08.16	New mat. Pos.201, new Pos.603	GVI	AHO EKB
02	26.08.15	AS BUILT	GVI	EAP EKB
01	22.05.14	AS BUILT	GVI	EAP EKB
A	01.07.13	ISSUED FOR COMMENTS	GVI	EAP EKB
Rev.	Date	Description	Prep	Chk App




Drawing title
Control Pod
General Arrangement
Mid Section

K Y S T D E S I G N A S
Strandgaten 202, 5525 Haugesund, NORWAY
Tel: +47 52 70 62 50
Fax: +47 52 70 62 01
www.kystdesign.no

Scale 2:5 Sheet 2
File name AD16-1150M01 of 6

In the information contained herein. Reproduction, use or disclosure to third parties without consent is strictly forbidden.
© KYSTDESIGN AS

SCALE 1:5

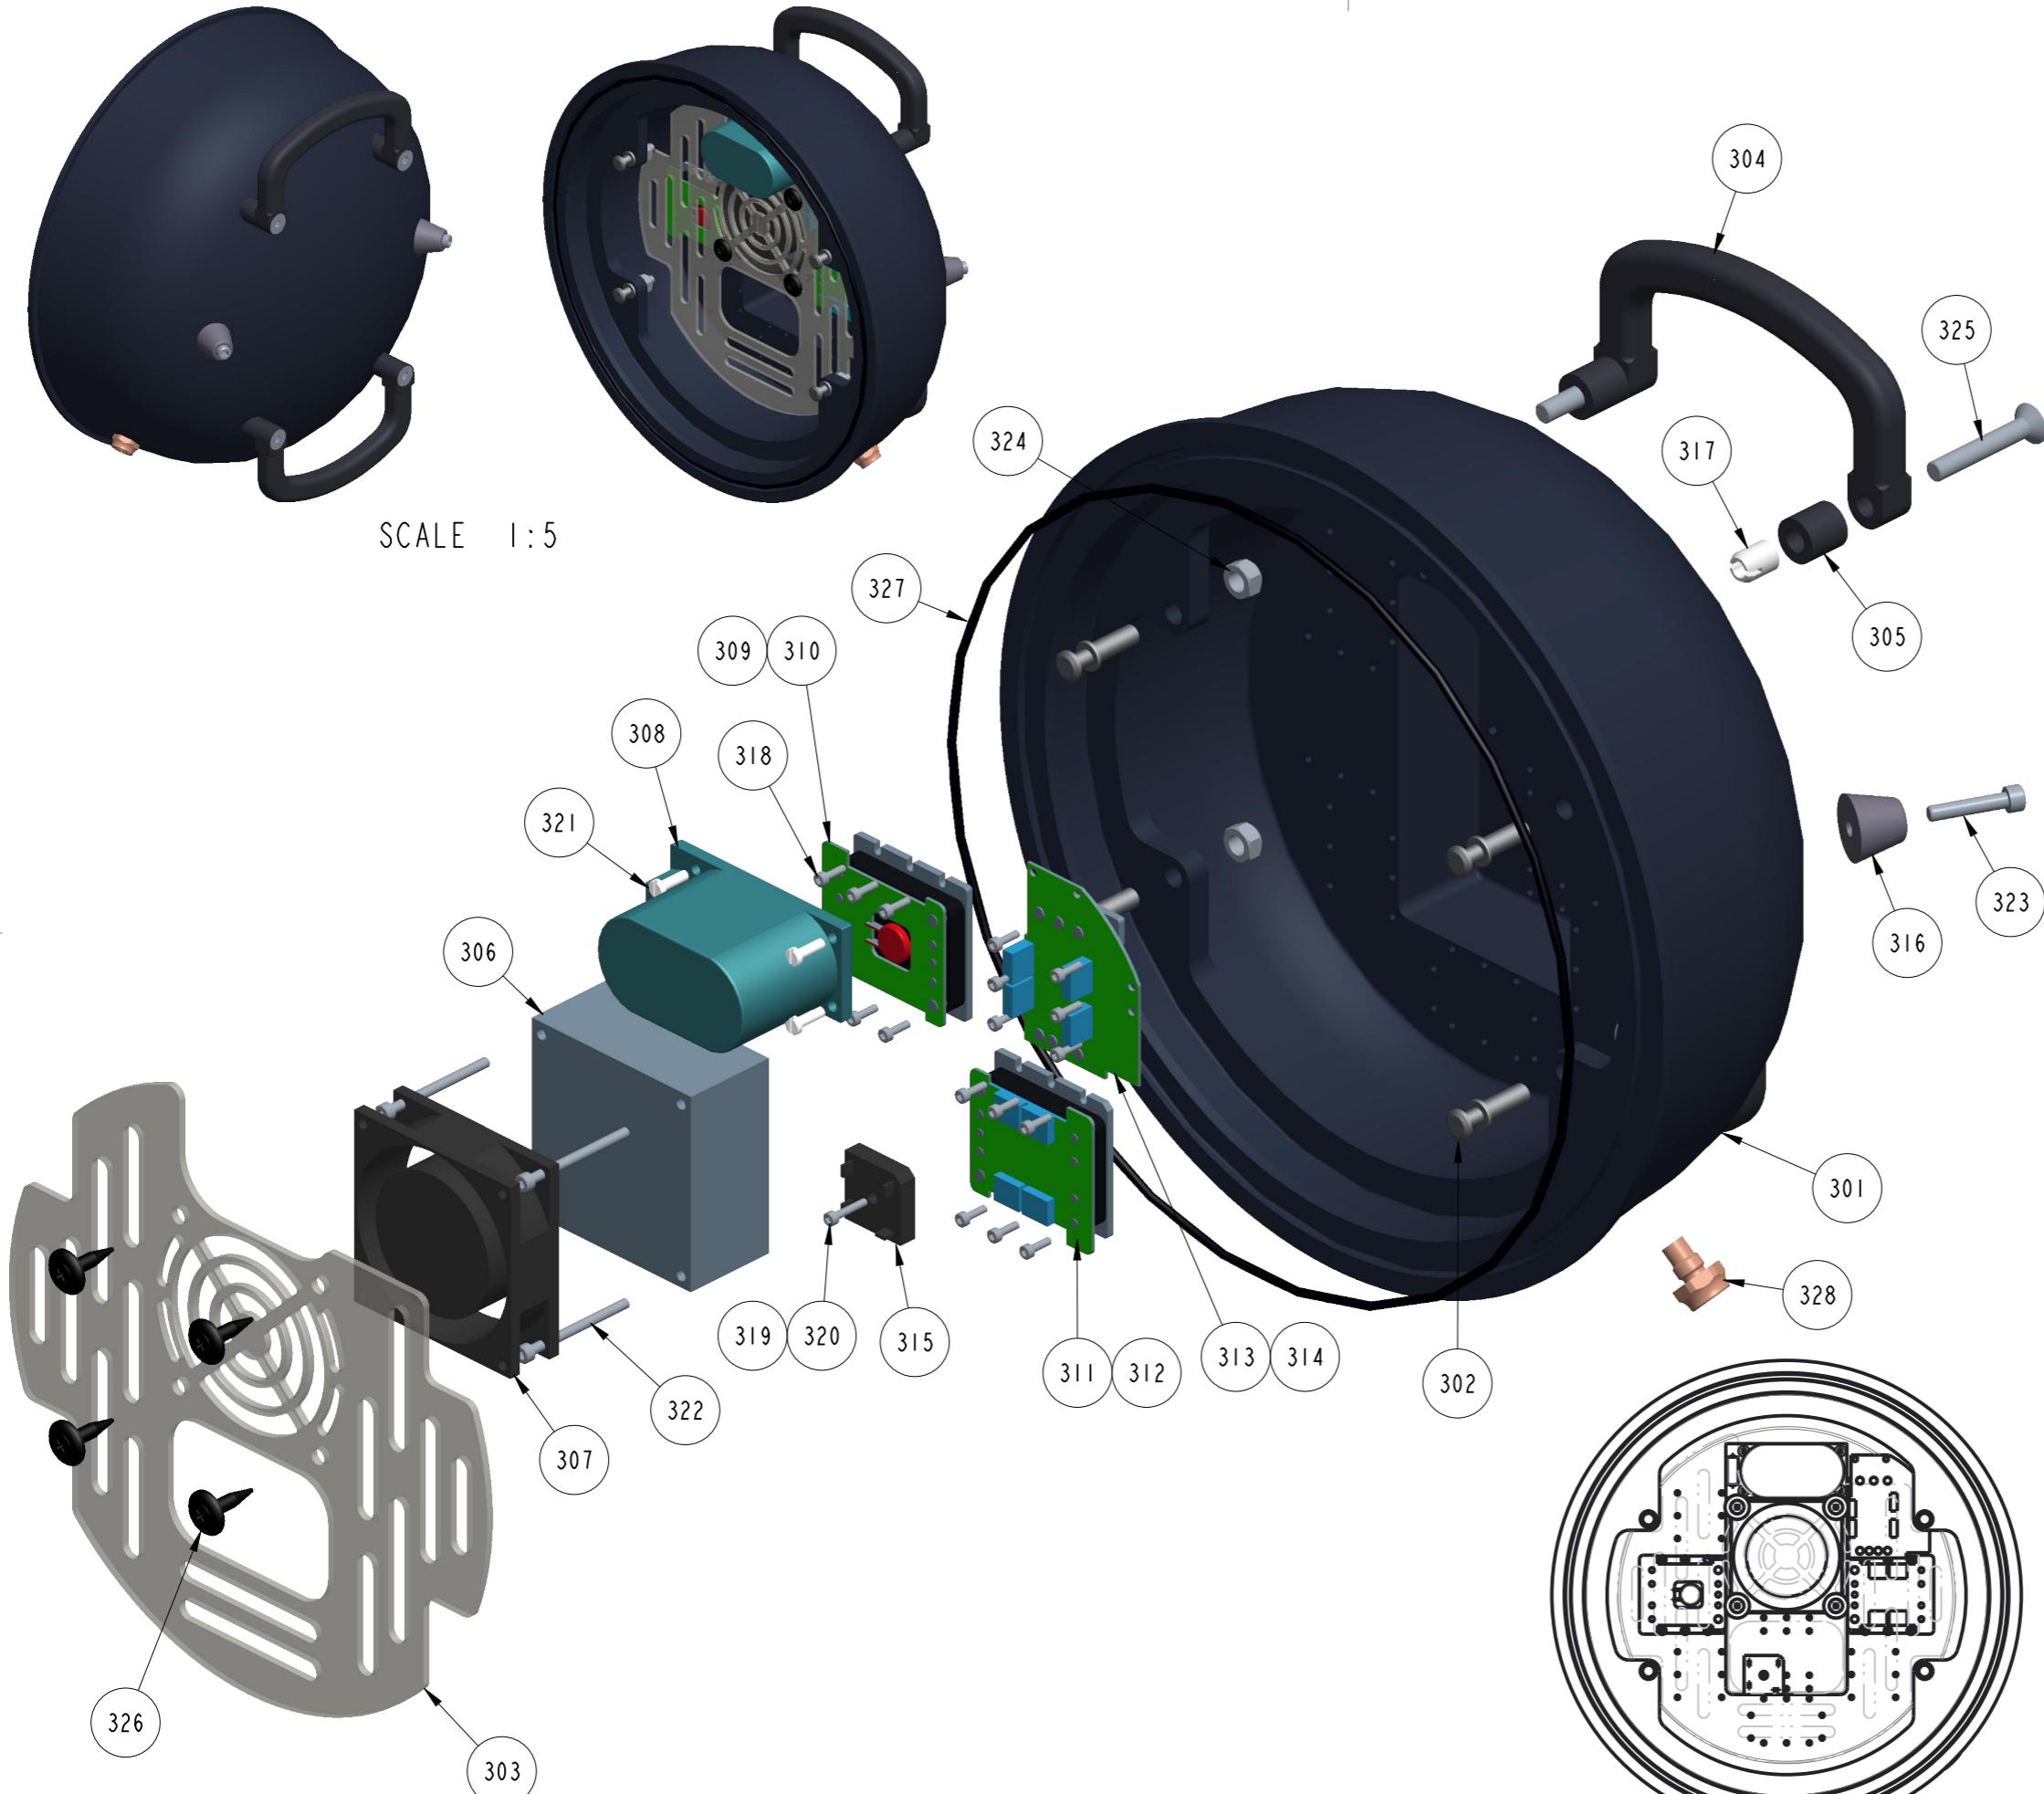

SCALE 1:5

Item.	Qty.	Description	Drg. / Spec.	Material
03	24.08.16	New mat. Pos.201, new Pos.603	GVI	AHO EKB
02	26.08.15	AS BUILT	GVI	EAP EKB
01	22.05.14	AS BUILT	GVI	EAP EKB
A	01.07.13	ISSUED FOR COMMENTS	GVI	EAP EKB
Rev.	Date	Description	Prep	Chk App

 **KYSTDESIGN**
SUB-SEA TECHNOLOGY


Drawing title
Control Pod
General Arrangement
End Dome



Size
A3

K Y S T D E S I G N A S
Strandgaten 202, 5525 Haugesund, NORWAY
Tel: +47 52 70 62 50
Fax: +47 52 70 62 01
www.kystdesign.no


Sheet
2:5
3
File name
AD16-1150M01
of
6

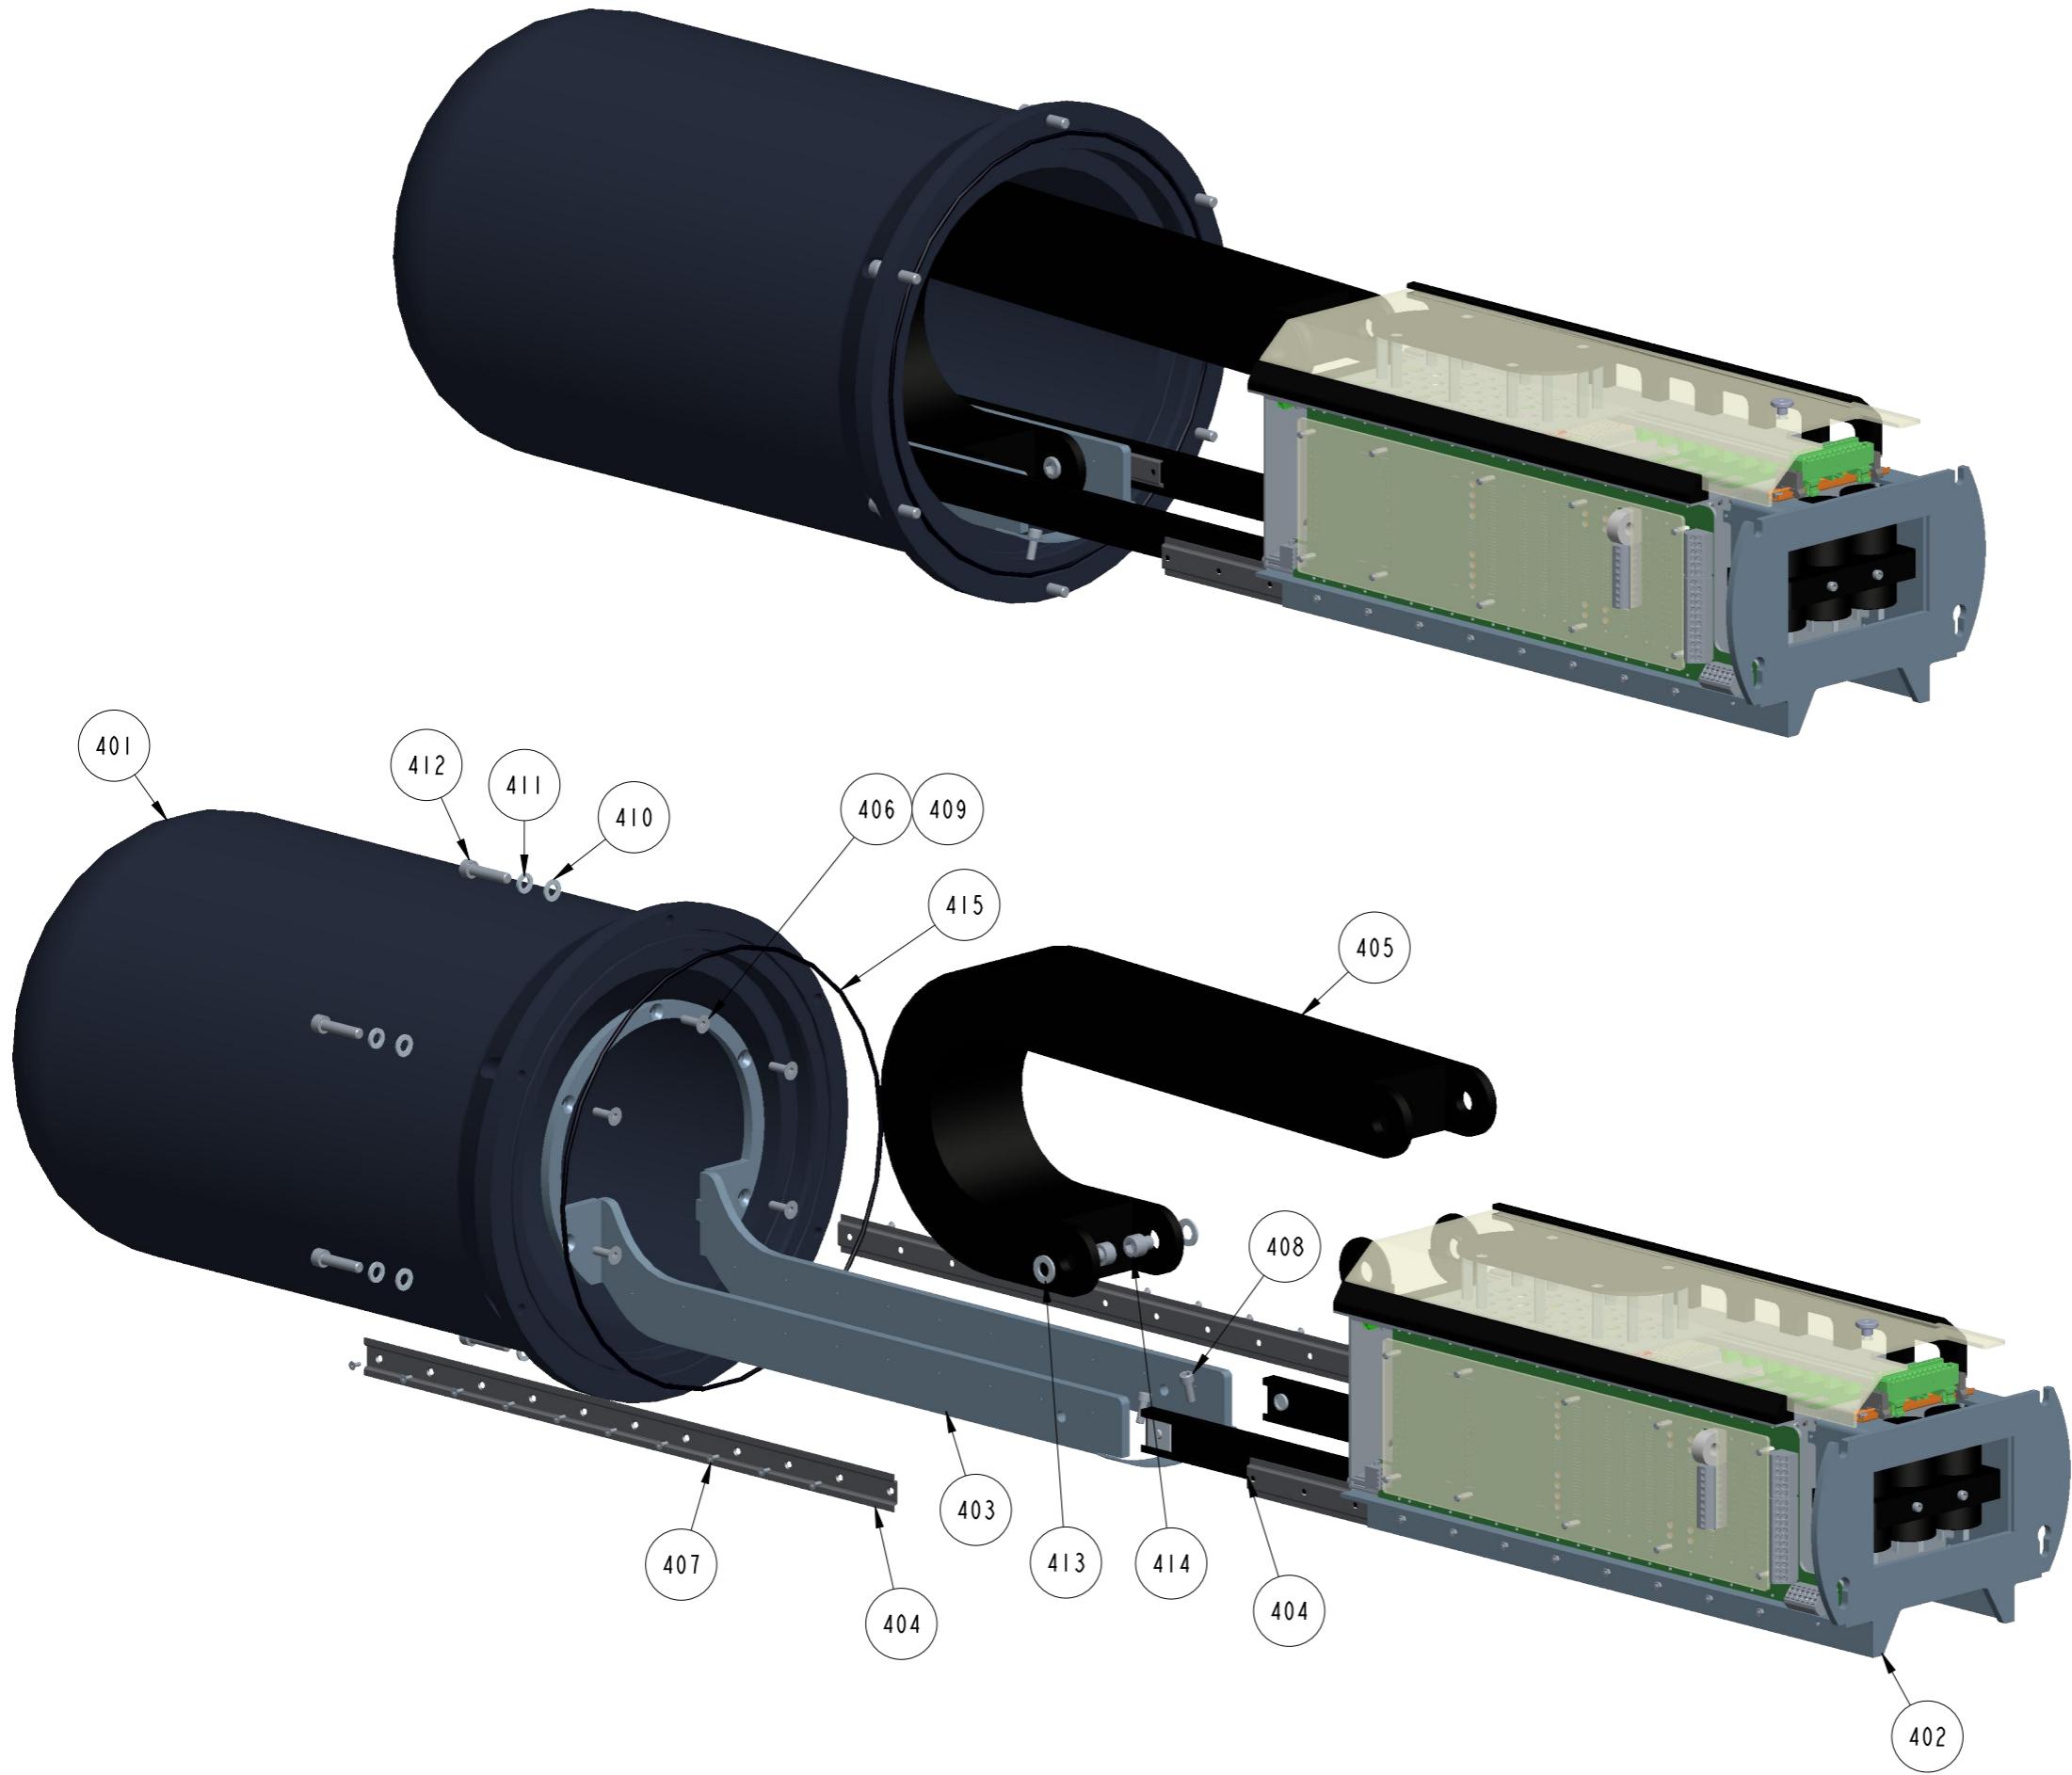


Item	Qty.	Description	Drg. / Spec.	Material
415	1	O-ring 313x3.53	I00416	NBR 70
414	2	Screw M10x10	DIN 912	A4
413	2	Washer M10	DIN 125	A4
412	6	Screw M8x35	DIN 912	A4
411	6	Lock Washer M8	DIN 127B	A4
410	6	Washer M8	DIN 125	A4
409	5	Screw M6x20	DIN 7991	A4
408	2	Screw M6x16	DIN 912	A4
407	20	Screw M3x8	DIN 7991	A4
406	5	Threaded fastener M6x14	ENSAT 30206050	SS
405	12	Energy Chain Element	I00130	
404	2	Telescopic Rail	Rollco-5012CN	AISI 316
403	1	Subrack Support	AB89-1050M20	
402	1	Subrack	Sheet 5	
401	1	Pressure Vessel	AB89-1050M13	ENAW 6082-T6
Itm. Qty.		Description	Drg. / Spec.	Material
03	24.08.16	New mat. Pos.201, new Pos.603	GVI	AHO EKB
02	26.08.15	AS BUILT	GVI	EAP EKB
01	22.05.14	AS BUILT	GVI	EAP EKB
A	01.07.13	ISSUED FOR COMMENTS	GVI	EAP EKB
Rev.	Date	Description	Prep	Chk App

 **KYSTDESIGN**
SUB-SEA TECHNOLOGY


Drawing title Control Pod General Arrangement Pressure Vessel	Size A3	□
		□
K Y S T D E S I G N A S Strandgaten 202, 5525 Haugesund, NORWAY Tel: +47 52 70 62 50 Fax: +47 52 70 62 01 www.kystdesign.no	Scale 1:5	Sheet 4
	File name AD16-1150M01	of 6

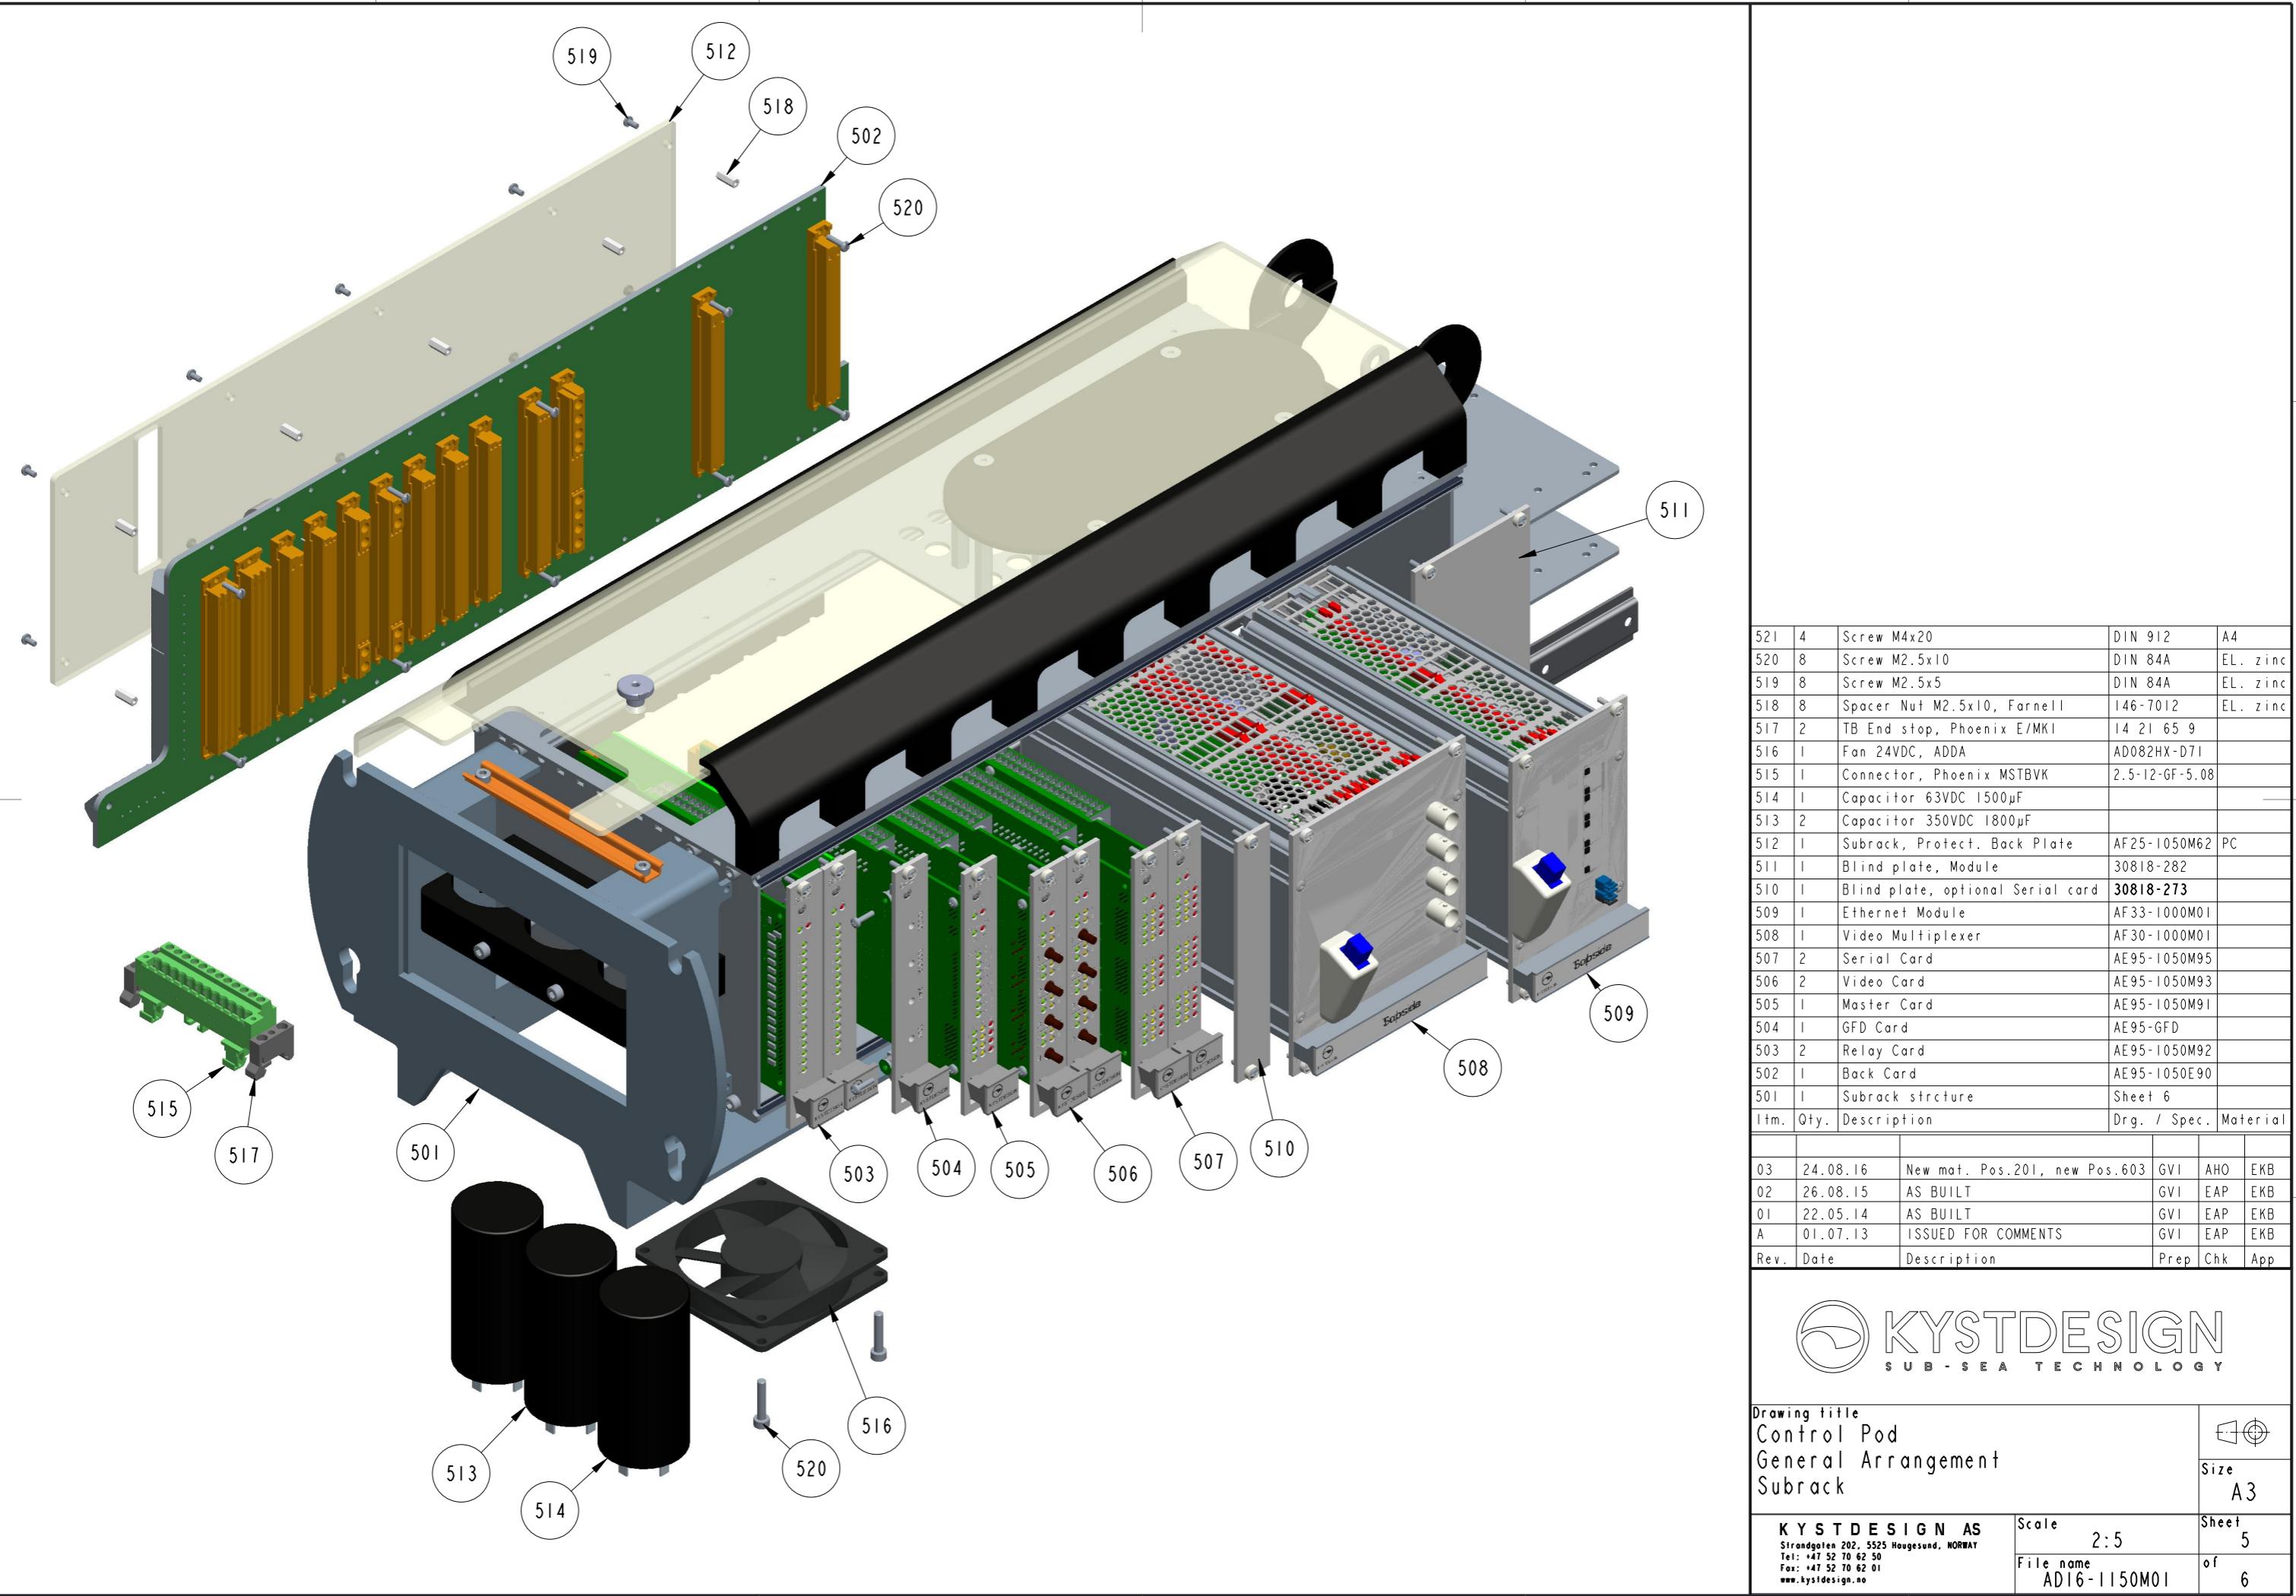


A

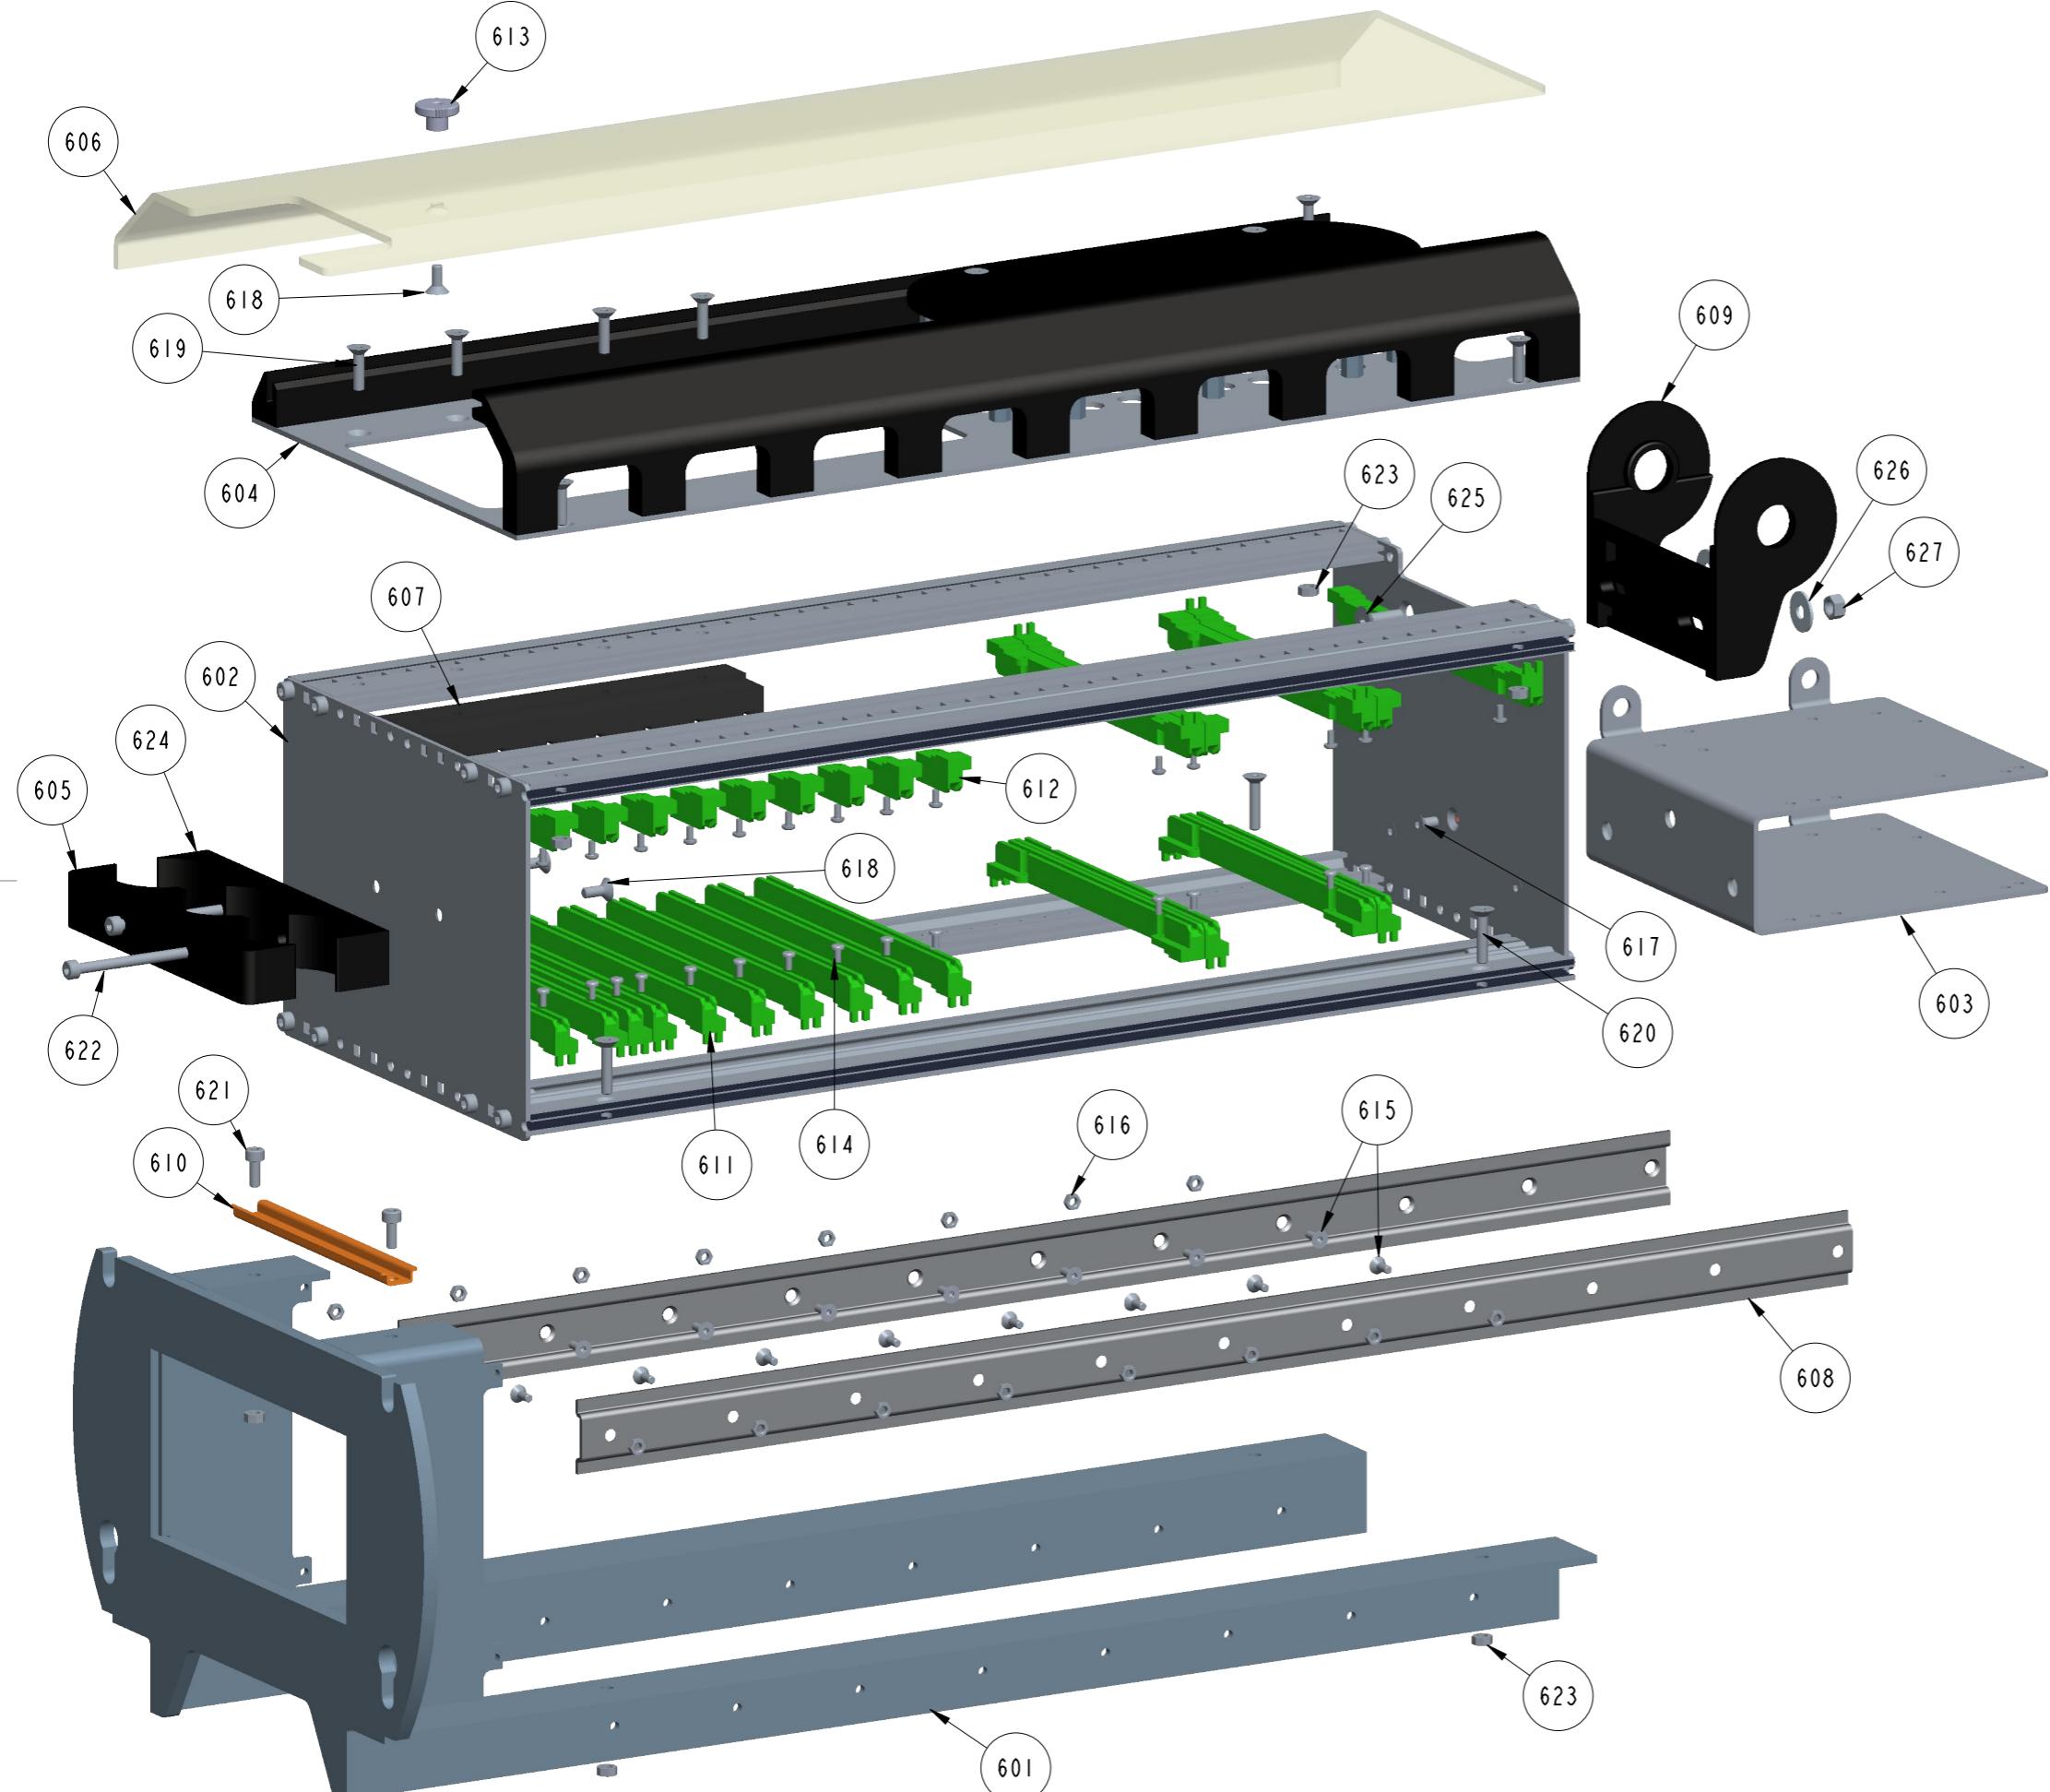


B

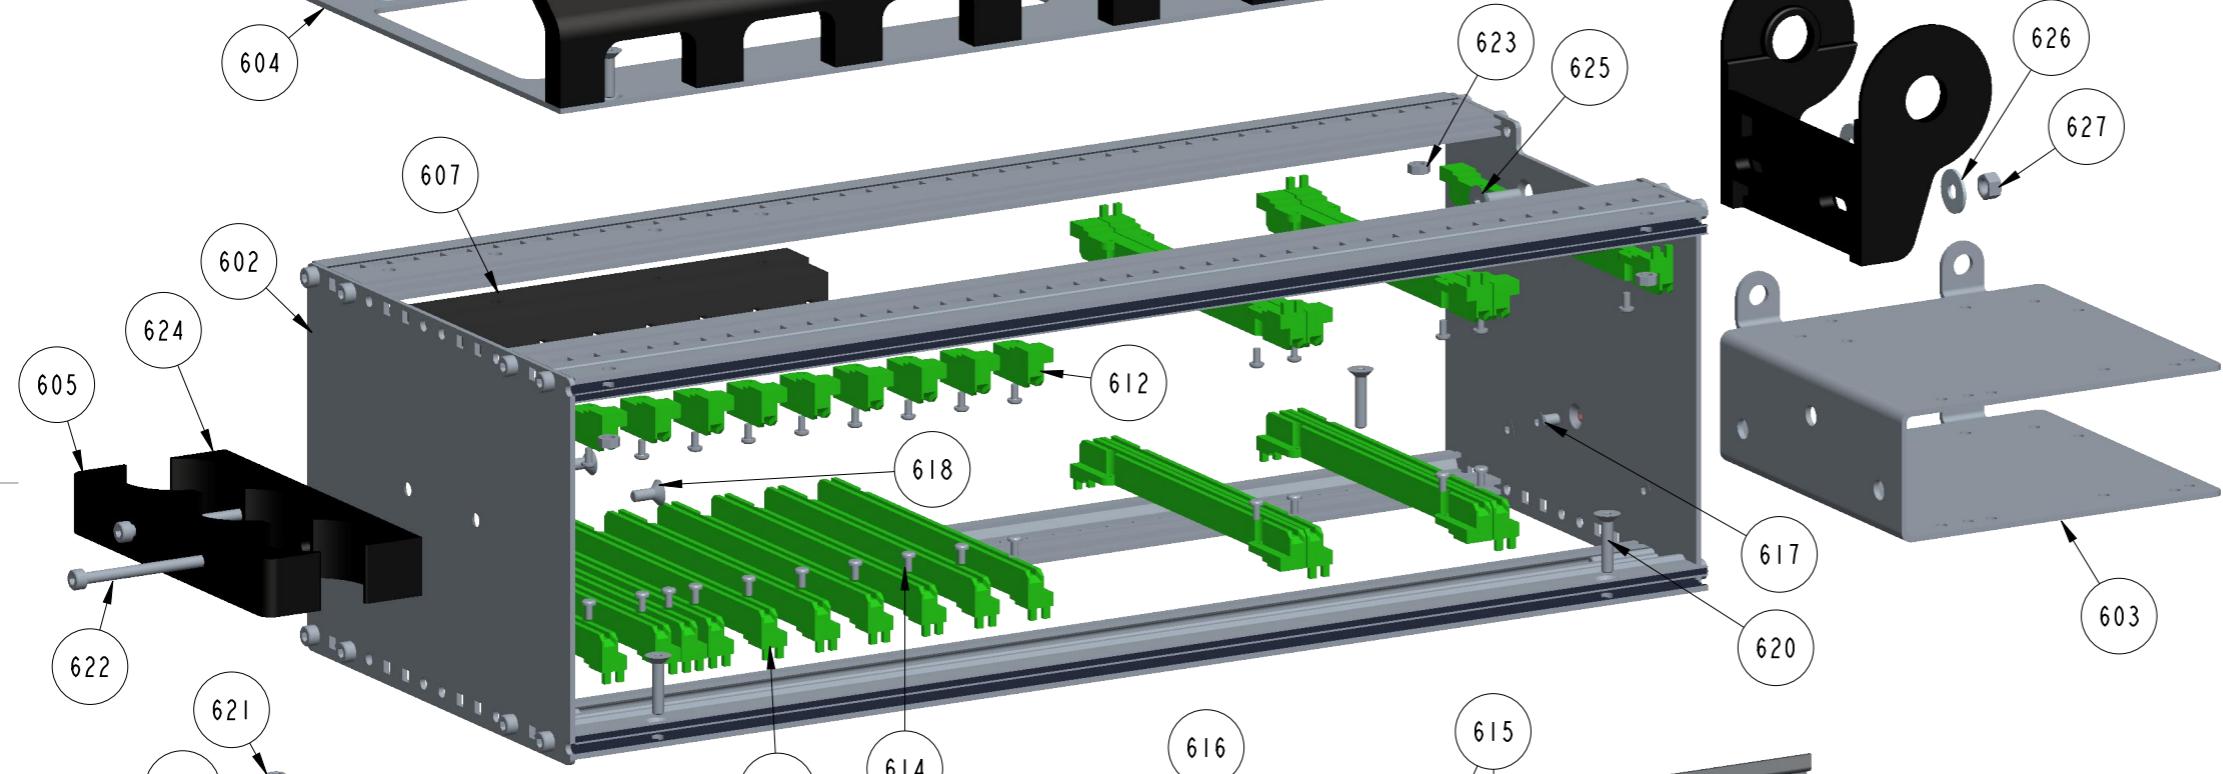

C

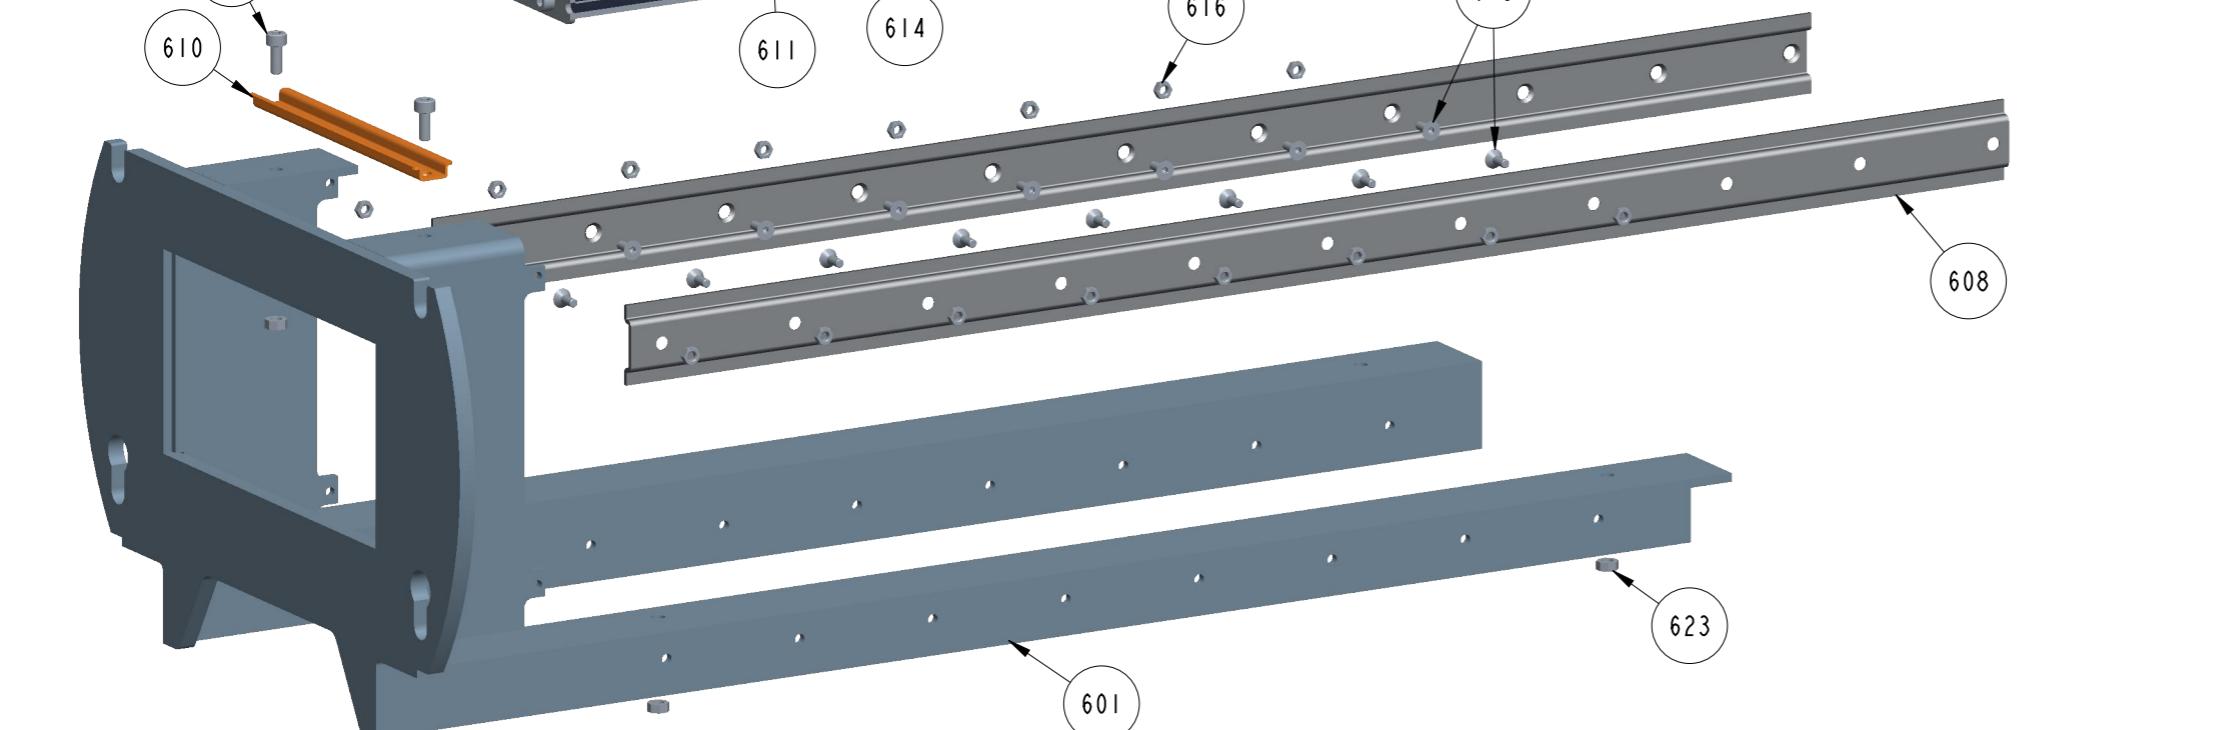

D

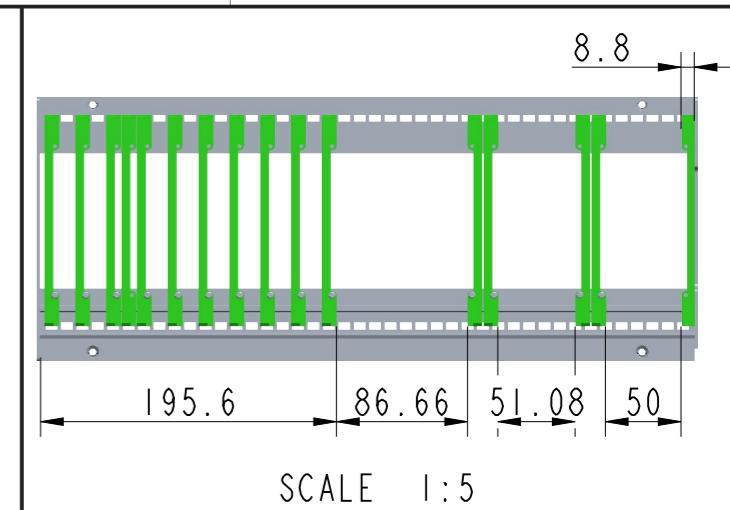

Itm.	Qty.	Description	Drg. / Spec.	Material
03	24.08.16	New mat. Pos.201, new Pos.603	GVI	AHO EKB
02	26.08.15	AS BUILT	GVI	EAP EKB
01	22.05.14	AS BUILT	GVI	EAP EKB
A	01.07.13	ISSUED FOR COMMENTS	GVI	EAP EKB
Rev.	Date	Description	Prep	Chk App

 **KYSTDESIGN**
SUB-SEA TECHNOLOGY

Drawing title Control Pod General Arrangement Subrack Structure	Size A3	Sheet 6
		of 6
K Y S T D E S I G N A S Strandgaten 202, 5525 Haugesund, NORWAY Tel: +47 52 70 62 50 Fax: +47 52 70 62 01 www.kystdesign.no	Scale 2:5	Sheet 6
	File name AD16-1150M01	of 6