


Tether

Termination Junction Box

Subsea Cable Assy

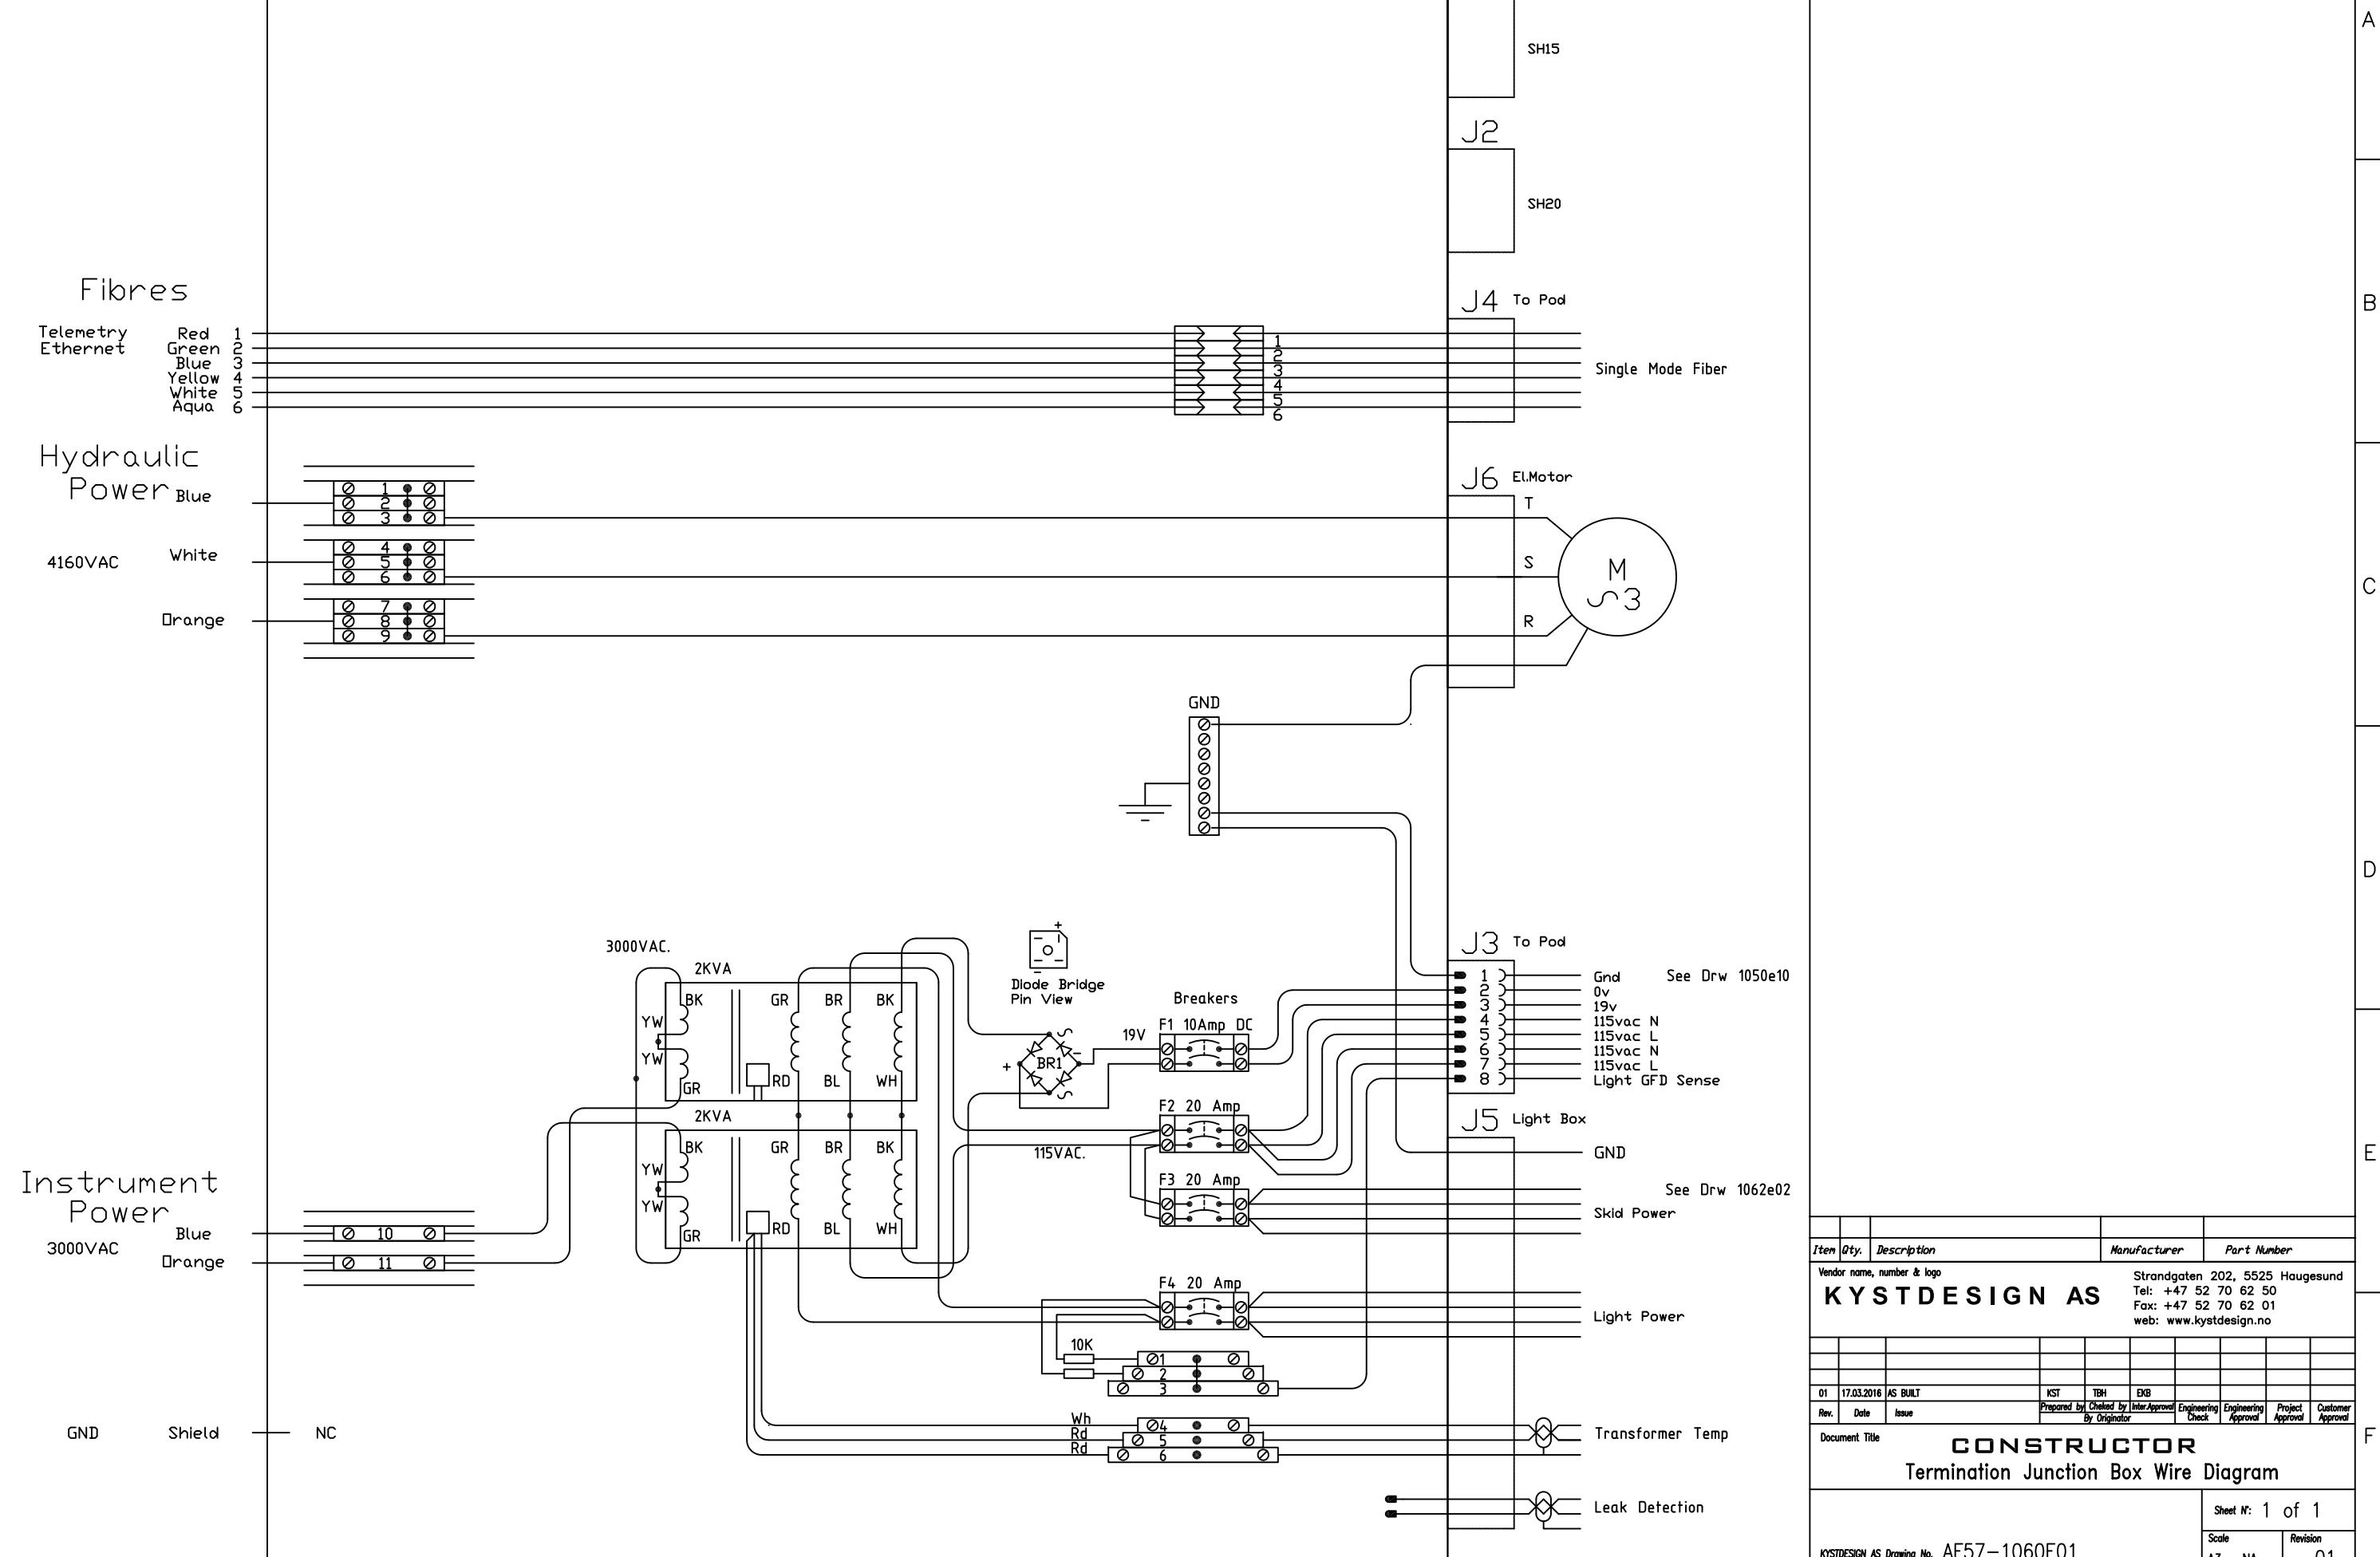

Item Qty.	Description	Manufacturer	Part Number
Vendor name, number & logo			
KYSTDESIGN AS			
Strandgaten 202, 5525 Haugesund Tel: +47 52 70 62 50 Fax: +47 52 70 62 01 web: www.kystdesign.no			
01	17.03.2016 AS BUILT	KST	EXB
Rev.	Date	Issue	Prepared by Checked by Inter Approved By Originator Engineering Check Engineering Approval Project Approval Customer Approval
Document Title			
CONSTRUCTOR Termination Junction Box Wire Diagram			
Sheet No: 1 of 1			
KYSTDESIGN AS Drawing No. AF57-1060E01			
Scale A3 - NA		Revision 01	