

AUTOCAD FORMAT

A

B

C

D

E

F

A


B

C

D

E

F

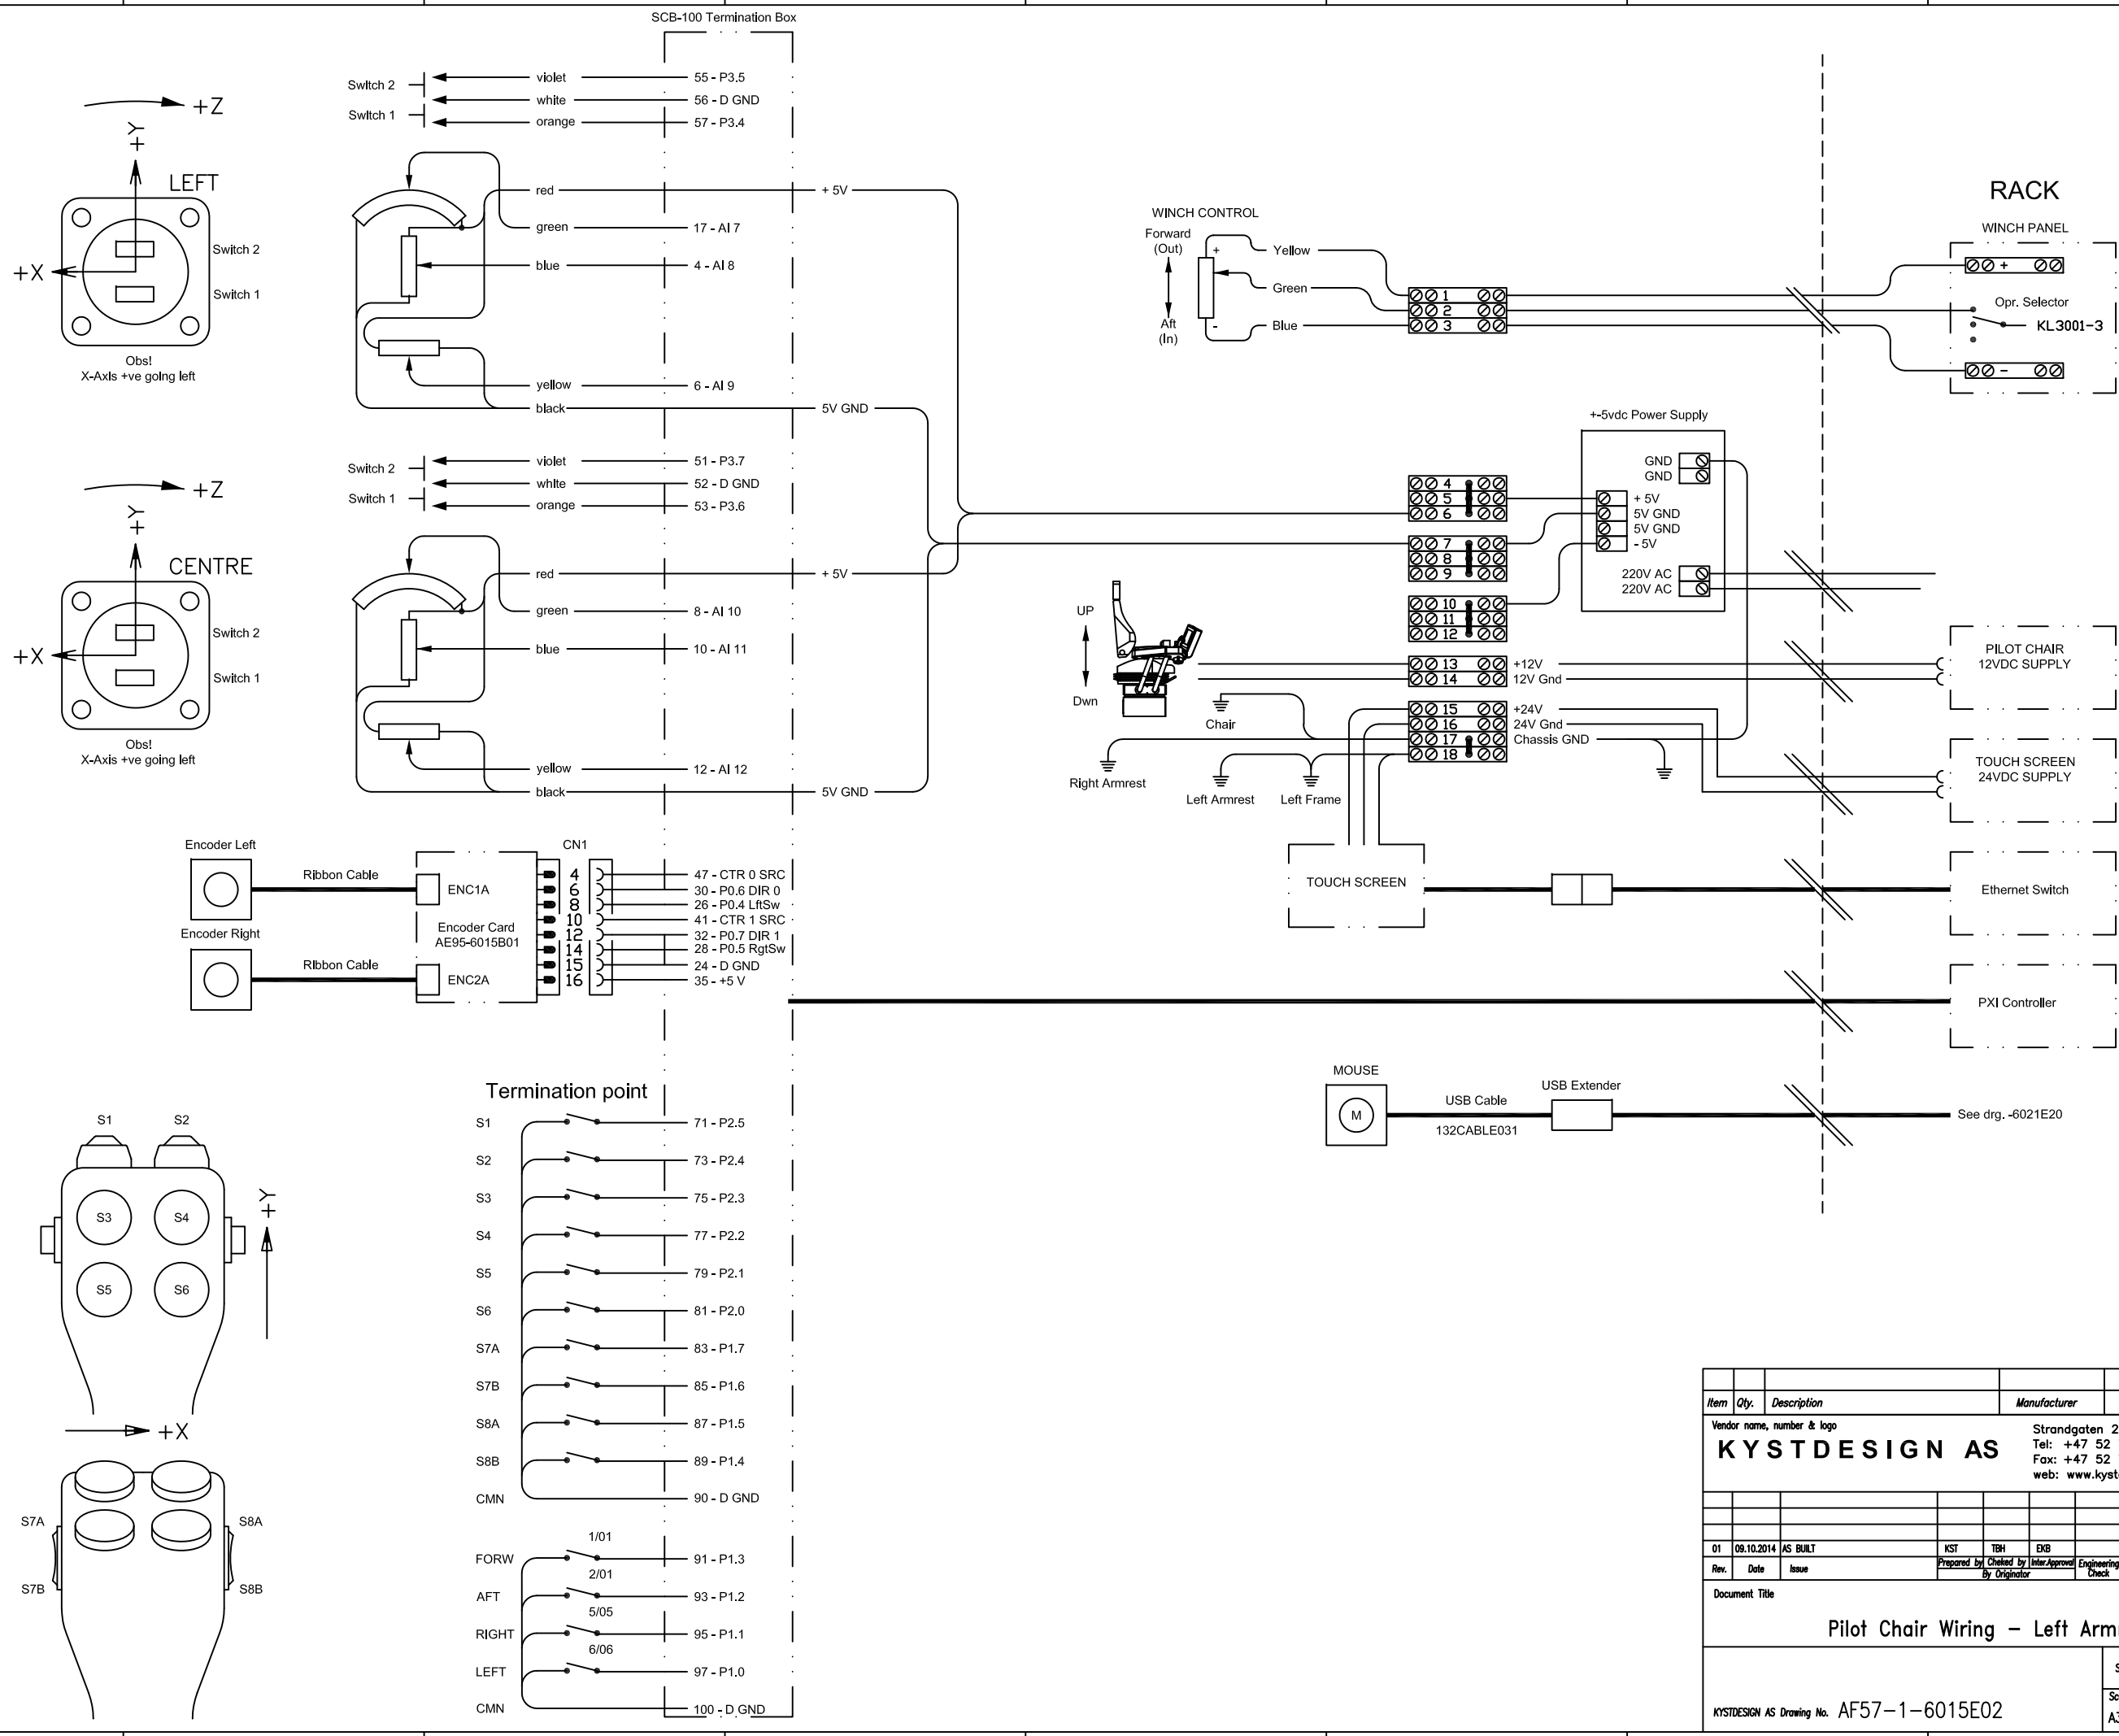

Item	Qty.	Description	Manufacturer	Part Number
Vendor name, number & logo			Strandgaten 202, 5525 Haugesund	
KYSTDESIGN AS			Tel: +47 52 70 62 50	
			Fax: +47 52 70 62 01	
			web: www.kystdesign.no	
01	09.10.2014	AS BUILT	KST	TBH
Rev.	Date	Issue	Prepared by	Checked by
			By Originator	Inter-Approval
			Engineering Check	Engineering Approval
			Project Approval	Customer Approval
Document Title				
Pilot Chair Wiring – Left Armrest				
KYSTDESIGN AS Drawing No. AF57-1-6015E02				Sheet No: 6.10.2015
				Scale
				A3 – NA
				Revision
				01