



TMS shown with bumper and top frame removed  
for clarity of internal parts and arrangements  
( 1 : 20 )

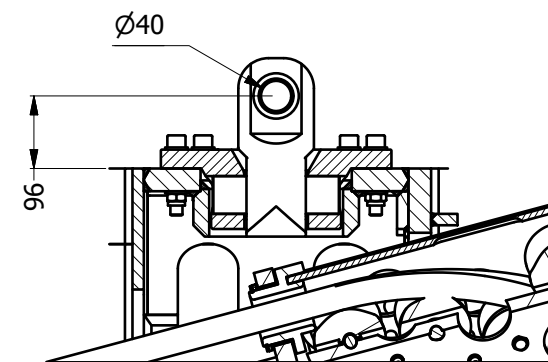

Section D-D  
( 1 : 10 )

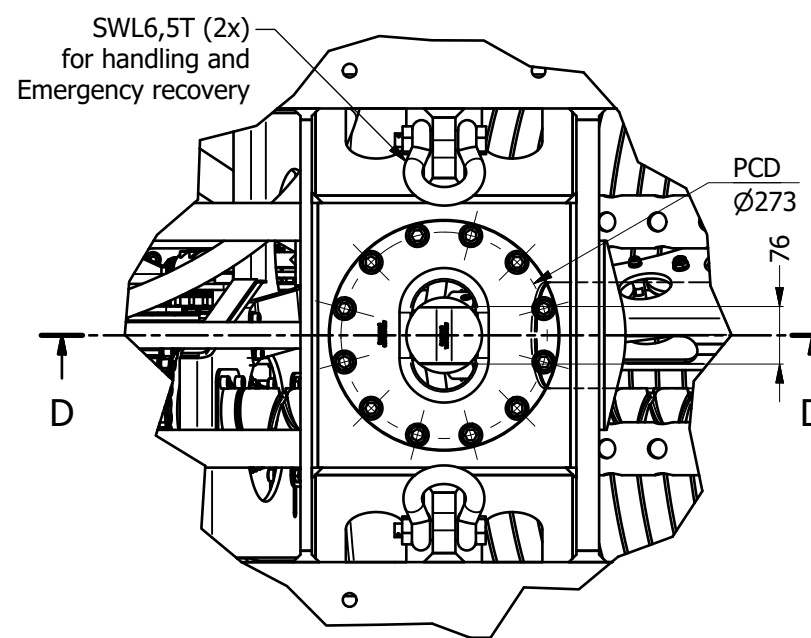

Detail C  
Lifting Link interface  
( 1 : 10 )

2	03.03.2016	Upd. As Built (1-3)/ for Constr.	MT	AHO	EKB
1'	14.12.2015	Updated for constr. /info.	MT	AHO	EKB
1	03.12.2015	Issued for Construction	MT	AHO	EKB
B	19.03.2015	Updated design, for info.	MT		
A	25.02.2015	Issued for information	MT		
Rev	Date	Description / Comments	Prep	Chk	Appr

## TMS KD-10


Drawing Title  
TMS assembly  
for Ø35 x 1000m Tether  
Iso overview / Lifting interface details



By TOLO ENGINEERING & DESIGN tolo@lyse.net (+47)99603153

Scale  
1:20 (10)

File Name / Dwg. No  
AF64-1000-M01

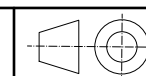

Sheet Size  
A3

Sheet No  
2  
of (sheets)

2