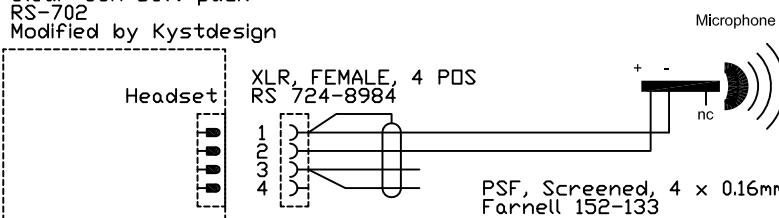



NOTE:

The Clear-Com belt pack is internally modified by Kystdesign AS.
The belt pack has also been programmed to match the microphone used.


Clear-Com Belt pack
RS-702
Modified by Kystdesign

Intercom

DBSI Modified

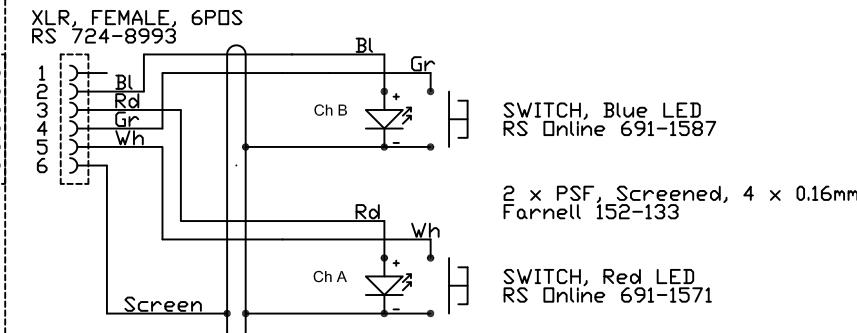


Intercon

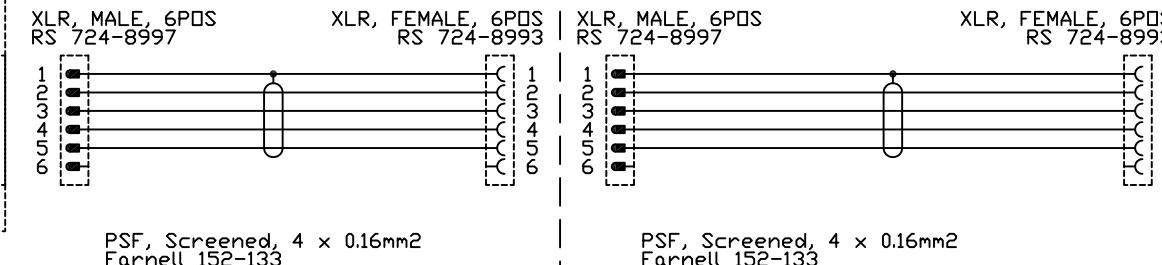

XLR, FEMALE, 6POS
RS 724-8993

Clear Com YC-36

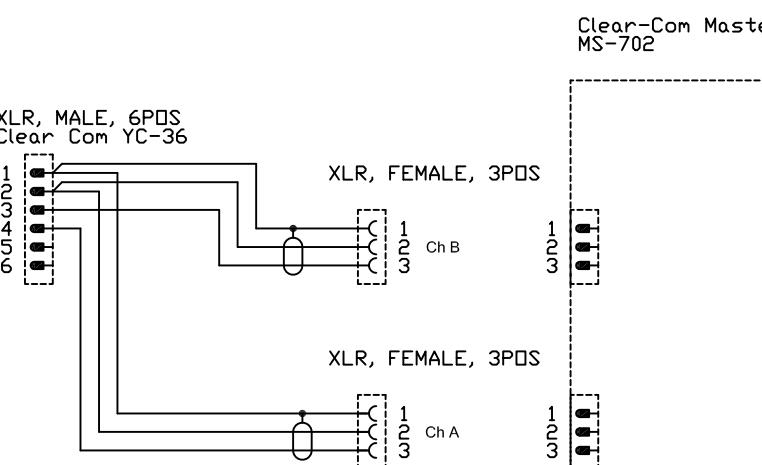

Item	Oty.	Description	Manufacturer	Part Number
Vendor name, number & logo				
KYSTDESIGN AS				
Strandgaten 202, 5525 Haugesund Tel: +47 52 70 62 50 Fax: +47 52 70 62 01 web: www.kystdesign.no				
01	24.06.2014	AS BUILT	KST	TBH
Rev.	Date	Issue	Prepared by	Checked by
			By Originator	InterApproved
			Engineering Check	Engineering Approval
			Project Approval	Customer Approval
Document Title				
Pilot Chair Wiring - Clear-Com				
Sheet N: 1 of 1				
KYSTDESIGN AS Drawing No. AF50-6015E03				Scale A3 - NA
				Revision 01