

AUTOCAD FORMAT

A

B

C

D

E

F

Drawing sheet size A3

1

2

3

4

5

6

7

8

A





B

C

D

E

F

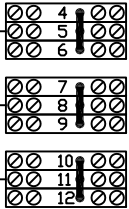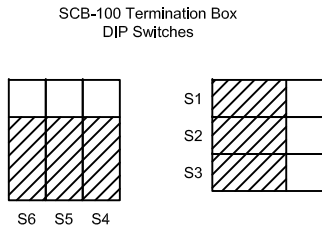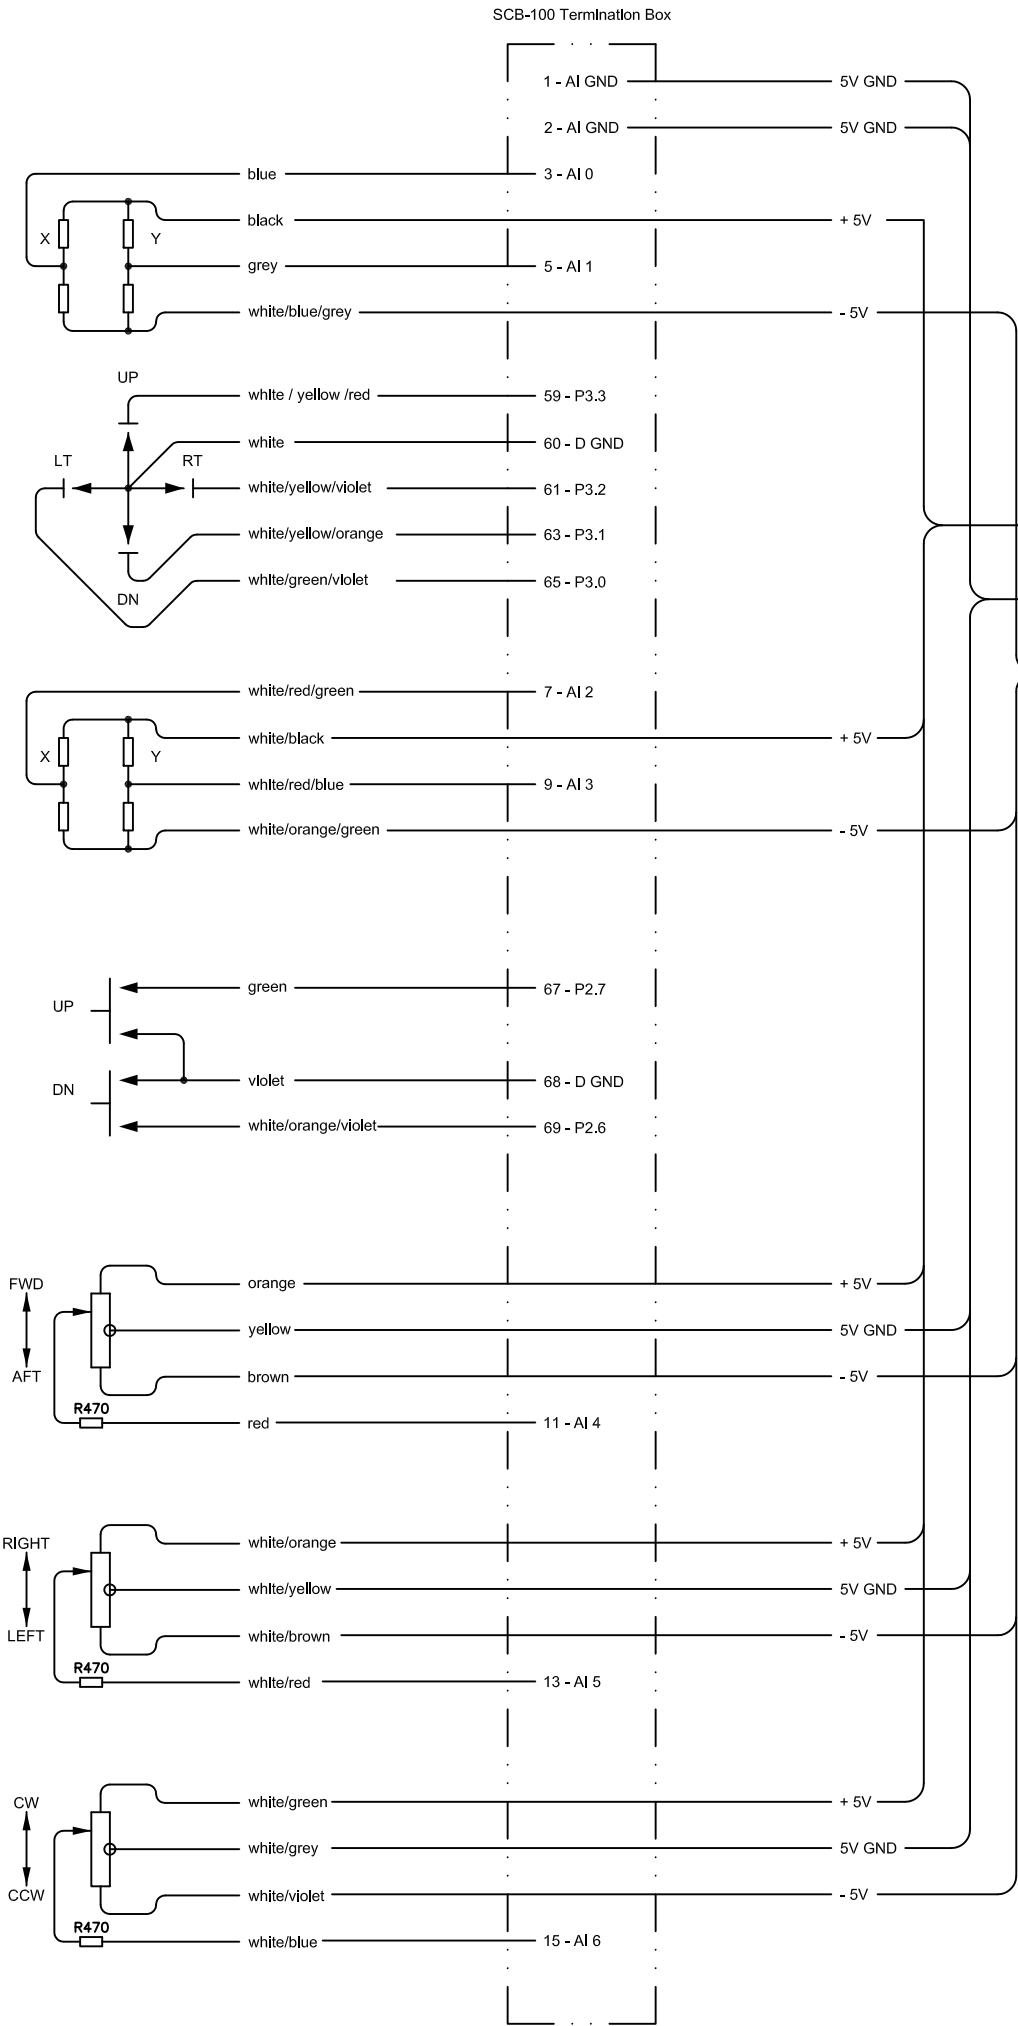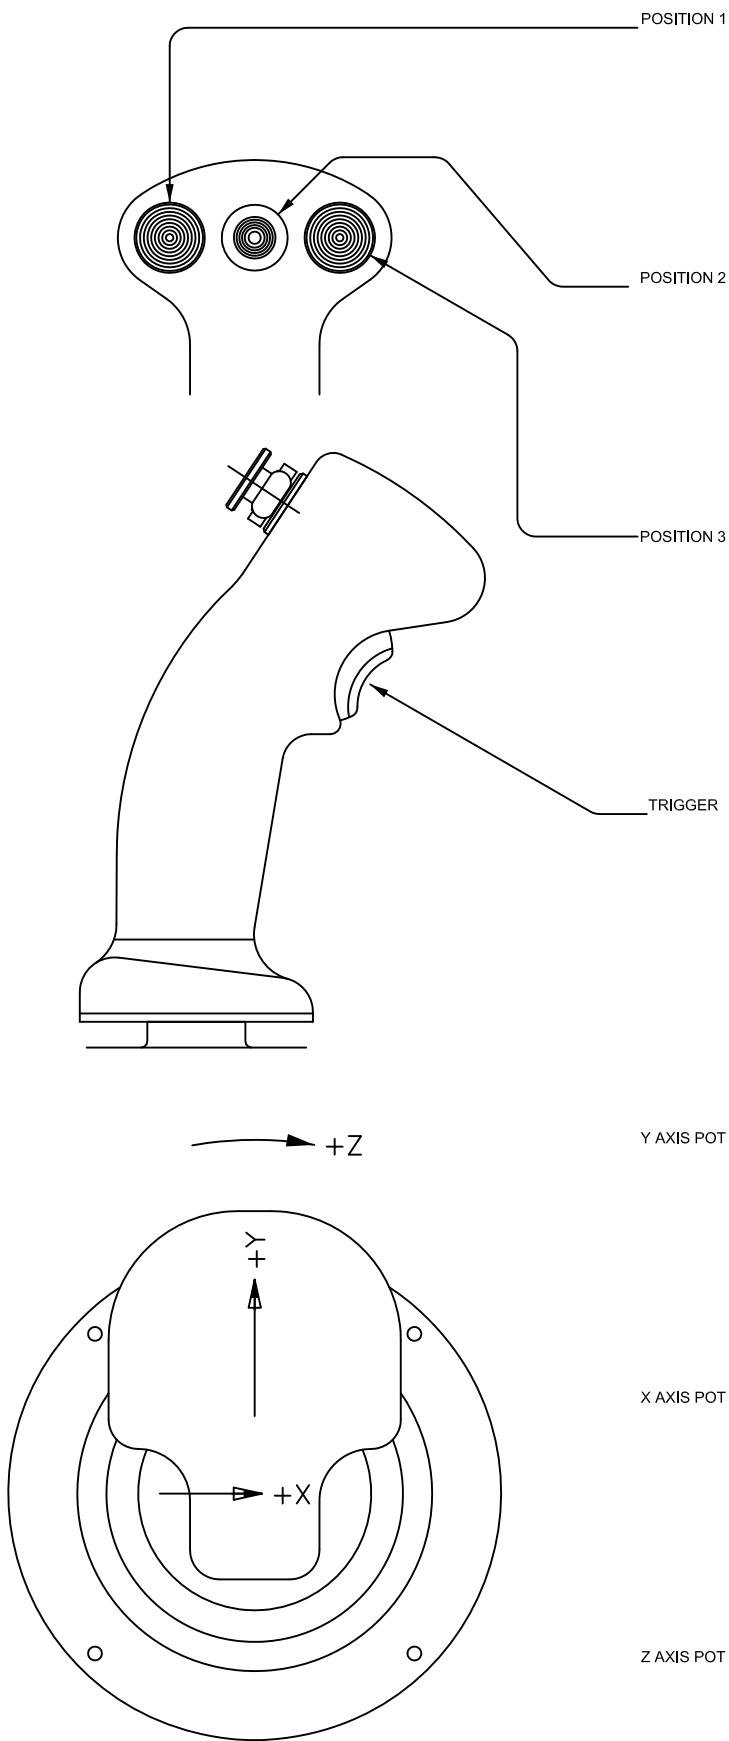

See Drawing 6015 E02

Item	Qty.	Description	Manufacturer	Part Number
Vendor name, number & logo			Strandgaten 202, 5525 Haugesund	
KYSTDESIGN AS			Tel: +47 52 70 62 50	
			Fax: +47 52 70 62 01	
			web: www.kystdesign.no	
01	19.06.2012	AS BUILT	KST	TBH
Rev.	Date	Issue	Prepared By	Checked By
			Inter-Approval	Engineering Check
			Engineering Approval	Project Approval
			Customer Approval	
Document Title				
Pilot Chair Wiring – Right Armrest				
KYSTDESIGN AS Drawing No. AF03–6015E01				Sheet N°: 1 of 1
				Scale A3 – NA
				Revision 01