




Termination Card

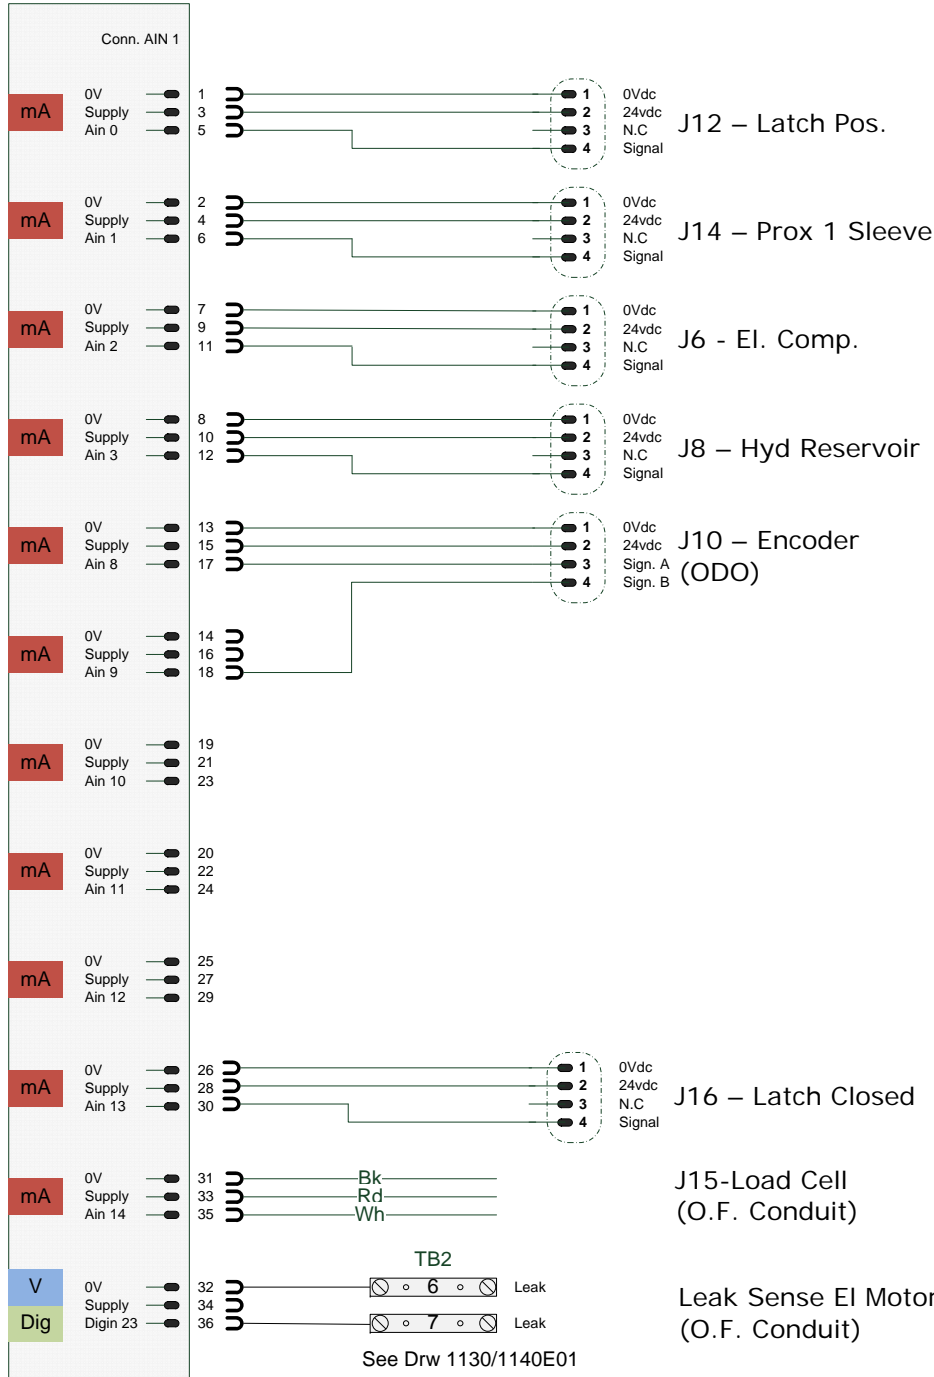


Termination Card

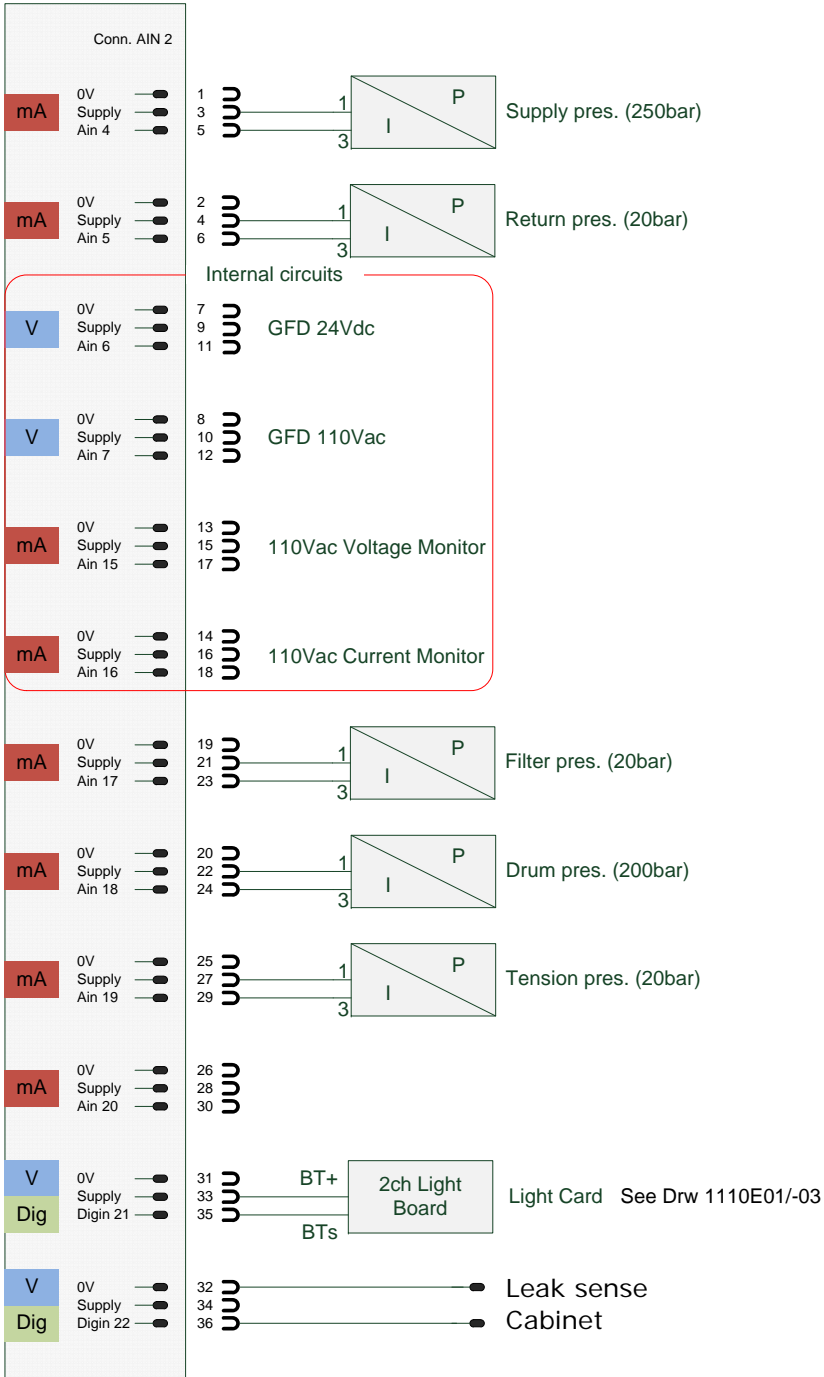

Termination Card

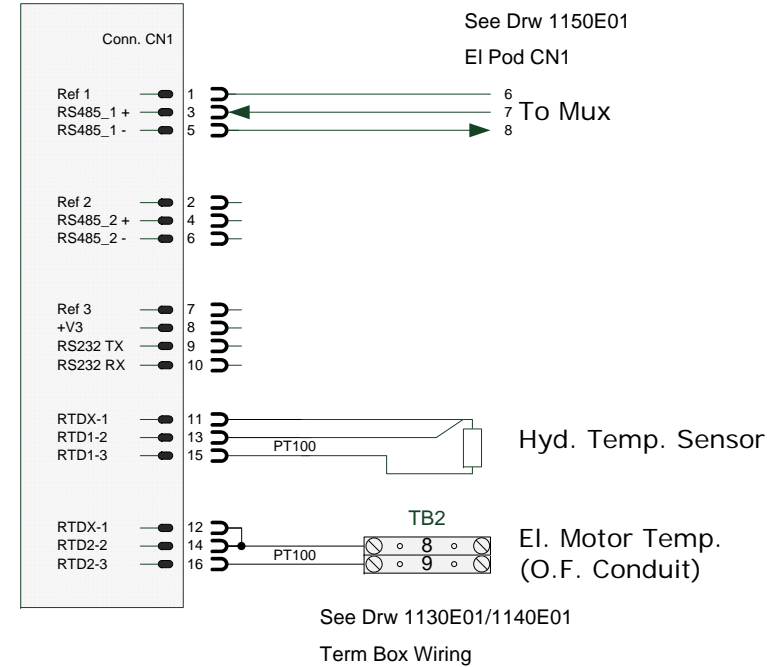

| REV  | DATE       | DESCRIPTION   | DRAWN BY          | APPROVED |
|--|------------|---|-------------------|----------|
| 01   | 18 03 2016 | As Built  | KST               | EKB      |
|  |            |  |                   |          |
| DESCRIPTION  |            |   | SIZE              | A3       |
| KD TMS<br>Cabinet Wire Diagram   |            |   | SHEET             | 1        |
| KYSTDESIGN AS<br>Strandgaten 202, 5525 Hagesund<br>NORWAY<br>Tel +47 52 70 62 50<br>Fax +47 52 70 62 01<br>www.kystdesign.no |            |   | OF                | 2        |
|  |            |   | DRAWING FILE NAME | REVISION |
|  |            |   | AF64-10-2-1110E02 | 1        |