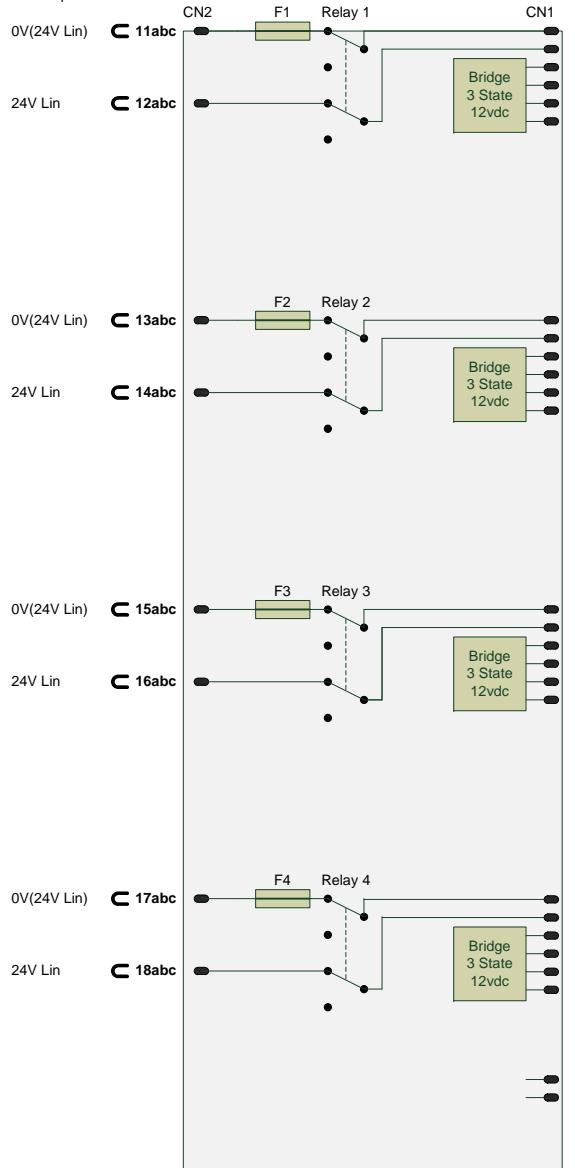
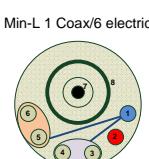
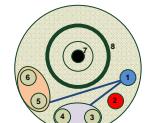


1 2 3 4 5 6 7 8

A

See Drw 1050E10
Power Wire Diagram

Backplane CN4

Master Card 1050E91**IP Camera 1****IP Camera 2****Min-L 1 Coax/6 electric**

Rev	Date	Issue	Prep. by	Ch. by	Appr. by
C	22 09 15	Draft	KST	TBH	EKB
1	17 03 16	As Built	KST	TBH	EKB



Strandgaten 202, 5525
Haugesund NORWAY
Tel +47 52 70 62 50
Fax +47 52 70 62 01
www.kystdesign.no

Document Title
Constructor 5 & 6
Control Pod Master Wire Diagram

Kystdesign AS Drawing No.

AF57-1-1050E27

SheetNo

1 of 1

Scale

A3

Revision

1

1 2 3 4 5 6 7 8